

MAR 08 1999

SECTION

LAND CORNER RECORDATION CERTIFICATE
Filing Requirement of Act 74, Mich. P.A. 1970
KENT COUNTY REMONUMENTATION

STATE OF MICHIGAN
COUNTY OF KENT
RECEIVED FOR RECORD
38 OCT 23 AM 9:58
REG. OF DEEDS

10809

Register of Deeds Stamp & File Number

For corners in

Kent (County)


Located in: Vergennes Township Corner Code #

- 1. Public Land Survey T 7N R 9W K-8
2. Property Controlling in Section S T R
3. Miscellaneous Property in Sec. S T R

- 4. Lot No. , Recorded Plat
5. Private Claims

I, Randy Kolehouse, in a field survey on January 13 19 98, do hereby certify that under requirements of P.A. 74 Michigan P.A. of 1970, the corner points mentioned in lines 1 and 2 above were in conformance with regulations and rules therefore as required in the current manual of survey instructions of the United States Department of the interior, Bureau of Land Management or by a decree of a Court of Law and/or that the corner points mentioned in lines 3, 4 and 5 above were in conformance with the rules of the Michigan Board of Land Surveyors or by a Decree of a Court of Law; established, re-established, monumented, re-monumented, recovered, found as expressed below:

NOTE: Not more than 4 corners, all in the same town and range, may be recorded on this certificate.

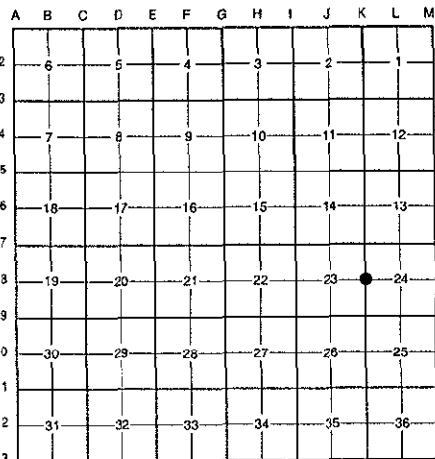

A. Description of original monument and accessories and/or subsequent restoration:


P.A. 345 1990 KENT COUNTY
PEER APPROVED 2/19/98
CHAIRMAN Harry Huber

This corner was originally approved by the Kent County Remonumentation Peer Group and monumented by T. Chettleburgh on 2/7/84 and was recorded per L.C.R.C. #3813.

B. Description of corner evidence found and/or method applied in restoring or reestablishing corner:

K-8 Found a Standard Kent County Monument at the intersection of fence lines running North, South, East and West per L.C.R.C.'s #3813 and #8258 as set by T. Chettleburgh in place of an iron pipe he found which checked a 1953 survey by Williams & Works and the K.C. Surveyor's records.

L.C.R.C. #3813

L.C.R.C. #8258

- Nail in NE side 21" Oak S53E 29.59'
Nail in NE side 12" Oak S24E 14.90'
Nail in W side 4" W Pine S7E 35.61'
Nail in S side 12" Oak N86W 23.56'
Nail in N side 9" Elm N84W 8.84'

The selected location is accepted by me and is generally accepted by professional surveyors as the best available evidence of the position of the original corner.

C. Description of monument for corner and accessories established to perpetuate locating the position of the corner:

- K-8 Standard Kent County Monument
Nail & K.C. remon. tag on NE side 24" Oak S 53° E 29.62'
Nail & K.C. remon. tag on NE side 15" Oak S 24° E 14.96'
Nail & K.C. remon. tag on W side 10" W. Pine S 07° E 35.72'
Nail & K.C. remon. tag on N side 12" Elm N 84° W 8.86'
Nail & K.C. remon. tag on W side 10" Elm N 00° E 8.05'
Nail & K.C. remon. tag on S side 12" Oak N 86° W 23.75'
On "X" of downed fence lines running N-S & E-W



Signed by Randy J. Kolehouse Date 9-1-98

EARTH TECH

Surveyor's Michigan License No. 25854