

MAR 08 1999

\$7.00  
\$2.00

LAND CORNER RECORDATION CERTIFICATE  
Filing Requirement of Act 74, Mich. P.A. 1970  
KENT COUNTY REMONUMENTATION

STATE OF MICHIGAN  
COUNTY OF KENT  
RECEIVED FOR RECORD  
38 OCT 23 AM 9:58  
REG. OF DEEDS  
*[Signature]*

SECTION

For corners in Kent (County) Located in: Vergennes Township Corner Code #

1. Public Land Survey	T <u>7N</u> R <u>9W</u>	<u>K-9</u>
	T _____ R _____	_____
	T _____ R _____	_____
	T _____ R _____	_____
2. Property Controlling in Section	S _____ T _____ R _____	_____
	S _____ T _____ R _____	_____
3. Miscellaneous Property in Sec.	S _____ T _____ R _____	_____
	S _____ T _____ R _____	_____


4. Lot No. \_\_\_\_\_, Recorded Plat \_\_\_\_\_

5. Private Claims \_\_\_\_\_

10810

Register of Deeds Stamp & File Number

I, Randy Kolehouse, in a field survey on January 14 19 98, do hereby certify that under requirements of P.A. 74 Michigan P.A. of 1970, the corner points mentioned in lines 1 and 2 above were in conformance with regulations and rules therefore as required in the current manual of survey instructions of the United States Department of the interior, Bureau of Land Management or by a decree of a Court of Law and/or that the corner points mentioned in lines 3, 4 and 5 above were in conformance with the rules of the Michigan Board of Land Surveyors or by a Decree of a Court of Law; established, re-established, monumented, re-monumented, recovered, found as expressed below:

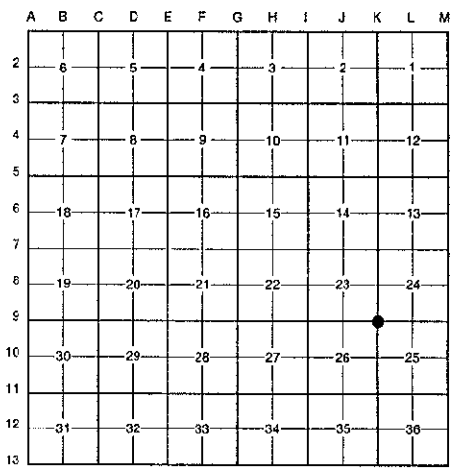

NOTE: Not more than 4 corners, all in the same town and range, may be recorded on this certificate.

A. Description of original monument and accessories and/or subsequent restoration:

K-9	1838	G.L.O. Notes	N. Brookfield	Set Post
	1953	Survey	Williams & Works	Iron
	1984	L.C.R.C. #3814	T. Chettleburgh	Fnd. Iron Pipe / Set K.C. Monument
	1995	L.C.R.C. #8259	William Byl	K.C. Monument

P.A. 345 1990 KENT COUNTY

PEER APPROVED 2/19/98  
CHAIRMAN [Signature]

This corner was originally approved by the Kent County Remonumentation Peer Group and monumented by T. Chettleburgh on 2/20/84 and was recorded per L.C.R.C. #3814.

B. Description of corner evidence found and/or method applied in restoring or reestablishing corner:

K-9 Found a Standard Kent County Monument per L.C.R.C.'s #3814 and #8259 as set by T. Chettleburgh in place of an iron pipe he found which checked the 1953 survey by Williams & Works.

L.C.R.C. #3814

L.C.R.C. #8259


- Nail in S side 10" W Cherry S84E 16.66'
- Nail in NE side 11" Elm S32E 35.57'
- Nail in W side 14" Elm S15W 45.10'
- Nail in SE side 12" W Cherry S61W 32.20'
- Iron Pipe West 10.99'

- Nail & KC Remon. tag S. side 15" W. Cherry S84°E 16.72' (m. 16.71')
- Nail & KC Remon. tag NE side 14" dead Elm S32°E 35.72' (m. 35.75')
- Nail & KC Remon. tag W. side 16" dead Elm S25°W 45.24' (m. 45.22')
- Nail & KC Remon. tag SE side 18" W. Cherry S61°W 32.27'
- Nail & KC Remon. tag E. side 12" Cherry S10°W 20.90' (m. 20.88')
- Nail & KC Remon. tag W. side 18" Oak N30°W 32.55' (m. 32.56')
- Iron Pipe N90°W 10.99' (m. 11.04')

The selected location is accepted by me and is generally accepted by professional surveyors as the best available evidence of the position of the original corner.

C. Description of monument for corner and accessories established to perpetuate locating the position of the corner:

- K-9 Standard Kent County Monument
- Nail & K.C. remon. tag on S side 16" W. Cherry S 84° E 16.71'
  - Nail & K.C. remon. tag on SE side 18" W. Cherry S 61° W 32.27'
  - Nail & K.C. remon. tag on E side 12" Cherry S 10° W 20.88'
  - Nail & K.C. remon. tag on W side 18" Oak N 30° W 32.56'
  - Nail & K.C. remon. tag on NE side 8" Hickory S 23° E 4.96'
  - Nail & K.C. remon. tag on SE side 8" Oak N 62° E 17.27'

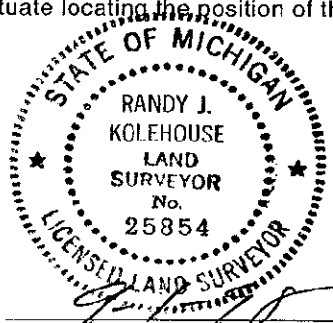

Signed by Randy J. Kolehouse Date \_\_\_\_\_  
EARTHTECH

Surveyor's Michigan License No. 25854