

SECURITY & REMONUMENTATION
 \$7.00
 \$2.00
 MAR 08 1999

STATE OF MICHIGAN
 COUNTY OF KENT
 RECEIVED FOR RECORD
 38 OCT 23 AM 9:58
 REG. OF DEEDS
Lucy St...

LAND CORNER RECORDATION CERTIFICATE
 Filing Requirement of Act 74, Mich. P.A. 1970
 KENT COUNTY REMONUMENTATION


For corners in

SECTION

<u>Kent</u> (County)	Located in: Vergennes Township	Corner Code #
1. Public Land Survey	T <u>7N</u> R <u>9W</u>	<u>K-11</u>
	T _____ R _____	_____
	T _____ R _____	_____
	T _____ R _____	_____
2. Property Controlling in Section	S _____ T _____ R _____	_____
	S _____ T _____ R _____	_____
3. Miscellaneous Property in Sec.	S _____ T _____ R _____	_____
	S _____ T _____ R _____	_____
4. Lot No. _____, Recorded Plat _____		
5. Private Claims _____		

10811
 Register of Deeds Stamp & File Number

I, Randy Kolehouse, in a field survey on January 16 19 98, do hereby certify that under requirements of P.A. 74 Michigan P.A. of 1970, the corner points mentioned in lines 1 and 2 above were in conformance with regulations and rules therefore as required in the current manual of survey instructions of the United States Department of the interior, Bureau of Land Management or by a decree of a Court of Law and/or that the corner points mentioned in lines 3, 4 and 5 above were in conformance with the rules of the Michigan Board of Land Surveyors or by a Decree of a Court of Law; established, re-established, monumented, re-monumented, recovered, found as expressed below:

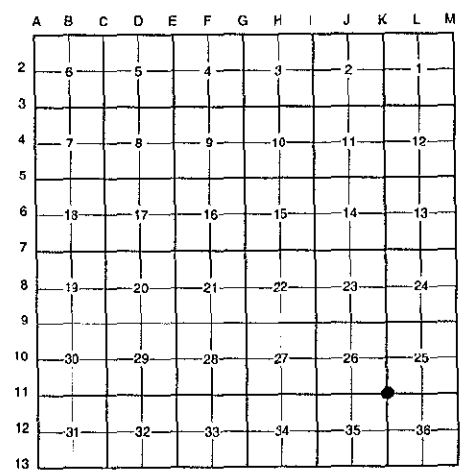

NOTE: Not more than 4 corners, all in the same town and range, may be recorded on this certificate.

A. Description of original monument and accessories and/or subsequent restoration:

K-11	1838	G.L.O. Notes	N. Brookfield	Set Post
	1894	Notes	Williams & Works	Cedar Stake
	N/A	Witness Map	K.C. Surveyor	Stake
	1955	Survey	Williams & Works	Set Stake
	1984	L.C.R.C. #3815	T. Chettleburgh	Fnd. Iron Pipe / Set K.C. Monument
	1995	L.C.R.C. #8263	William Byl	K.C. Monument

P.A. 345 1990 KENT COUNTY
 PEER APPROVED 2/19/98
 CHAIRMAN *Harry Huber*

This corner was originally approved by the Kent County Remonumentation Peer Group and monumented by T. Chettleburgh on 2/23/84 and was recorded per L.C.R.C. #3815.

B. Description of corner evidence found and/or method applied in restoring or reestablishing corner:


K-11 Found a Standard Kent County Monument 764.3' ± East of the C/L intersection of Flat River Drive running Northeast and Southwest and Vergennes Street running West per L.C.R.C.'s #3815 and #8263 as set by T. Chettleburgh in place of an iron pipe he found which checked the 1894 and 1955 records of Williams & Works and the K.C. Surveyor's records.

L.C.R.C. #3815	L.C.R.C. #8263
Nail in NE side 30" Oak N79E 17.98'	Nail & KC Remon. tag NE side 33" Oak N79°E 18.01' (m. 17.99')
Nail in W side 43" Oak S11E 130.16'	Nail & KC Remon. tag W. side 48" Oak S11°E 130.21' (m. 130.16')
Nail in W side Tri 10", 16", 20" Oak S8W 251.54'	Nail & KC Remon. tag W. side Tri. 12"-24" Oak S08°W 251.58' (m. 251.54')

The selected location is accepted by me and is generally accepted by professional surveyors as the best available evidence of the position of the original corner.

C. Description of monument for corner and accessories established to perpetuate locating the position of the corner:

- K-11 Standard Kent County Monument
 - Nail & K.C. remon. tag on NE side 33" Oak N 79° E 17.99'
 - Nail & K.C. remon. tag on W side 48" Oak S 11° E 130.16'
 - Nail & K.C. remon. tag on W side triple 12"-24" Oak S 08° W 251.54'
 - C/L intersection of Vergennes Street and Flat River Drive, West 764.3 ±

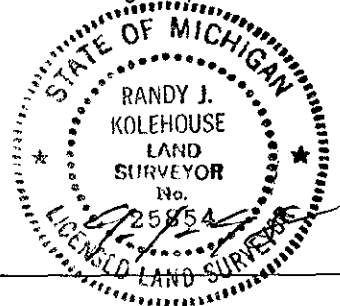

Signed by *Randy J. Kolehouse* Date _____
 EARTHTECH
 Surveyor's Michigan License No. 25854