

MAR 08 1999

\$7.00  
\$2.00

SECTION

LAND CORNER RECORDATION CERTIFICATE  
Filing Requirement of Act 74, Mich. P.A. 1970  
KENT COUNTY REMONUMENTATION

STATE OF MICHIGAN  
COUNTY OF KENT  
RECEIVED FOR RECORD  
38 OCT 23 AM 9:58  
REG. OF DEEDS  
*Luigi Standa*

10812

Register of Deeds Stamp & File Number

For corners in Kent (County) Located in: Vergennes Township Corner Code #

1. Public Land Survey	T <u>7N</u> R <u>9W</u>	<u>K-12</u>
	T _____ R _____	_____
	T _____ R _____	_____
	T _____ R _____	_____
2. Property Controlling in Section	S _____ T _____ R _____	_____
	S _____ T _____ R _____	_____
3. Miscellaneous Property in Sec.	S _____ T _____ R _____	_____
	S _____ T _____ R _____	_____

4. Lot No. \_\_\_\_\_, Recorded Plat \_\_\_\_\_  
5. Private Claims \_\_\_\_\_

A	B	C	D	E	F	G	H	I	J	K	L	M
2	6	5	4	3	2	1						
3												
4	7	8	9	10	11	12						
5												
6	18	17	16	15	14	13						
7												
8	19	20	21	22	23	24						
9												
10	30	29	28	27	26	25						
11												
12	31	32	33	34	35	36						
13												

I, Randy Kolehouse, in a field survey on January 16 19 98, do hereby certify that under requirements of P.A. 74 Michigan P.A. of 1970, the corner points mentioned in lines 1 and 2 above were in conformance with regulations and rules therefore as required in the current manual of survey instructions of the United States Department of the interior, Bureau of Land Management or by a decree of a Court of Law and/or that the corner points mentioned in lines 3, 4 and 5 above were in conformance with the rules of the Michigan Board of Land Surveyors or by a Decree of a Court of Law; established, re-established, monumented, re-monumented, recovered, found as expressed below:

NOTE: Not more than 4 corners, all in the same town and range, may be recorded on this certificate.

A. Description of original monument and accessories and/or subsequent restoration:

K-12	1838	G.L.O. Notes	N. Brookfield	Set Post
	1976	L.C.R.C. #978	Exxel Engineering	Set Capped Iron
	1981	L.C.R.C. #1994	Jonker Land Survey	Fnd. Capped Iron / Set K.C. Monument
	1995	L.C.R.C. #8264	William Byl	K.C. Monument

This corner was originally approved by the Kent County Remonumentation Peer Group and monumented by Rob Jonker on 8/13/81 and was recorded per L.C.R.C. #1994.

B. Description of corner evidence found and/or method applied in restoring or reestablishing corner:

K-12 Found a Standard Kent County Monument 50' ± South of power lines running E-W, 35' ± North of walking path running E-W, on line of a tree row and fence line running East and a downed fence line running South, per L.C.R.C.'s #1994 and #8264 as set by Rob Jonker in place of a capped iron he found which checked L.C.R.C. #978.

L.C.R.C. #1994

L.C.R.C. #8264


Remon. tag on S side 14" Oak S08°E 48.48'	Nail & KC Remon. tag S. side 22" Oak S08°E 48.58' (m. 48.65')
Remon. tag on SW side 5" Maple S53°E 7.92'	Nail & KC Remon. tag SW side 10" Maple S53°E 7.88' (m. 7.91')
Remon. tag on SE side 9" Oak S54°W 56.84'	Nail & KC Remon. tag SE side 14" Oak S54°W 57.04' (m. 57.04')

The selected location is accepted by me and is generally accepted by professional surveyors as the best available evidence of the position of the original corner.

C. Description of monument for corner and accessories established to perpetuate locating the position of the corner:

- K-12 Standard Kent County Monument
- Nail & K.C. remon. tag on S side 22" Oak S 08° E 48.65'
  - Nail & K.C. remon. tag on SW side 10" Maple S 53° E 7.91'
  - Nail & K.C. remon. tag on SE side 14" Oak S 54° W 57.04'
  - Nail & K.C. remon. tag on S side 4" Elm S 60° W 2.83'
  - Nail & K.C. remon. tag on E side 16" Twin Oak S 29° E 61.82'
  - On tree row and fence line running E
  - On downed fence line running S
  - Power lines running E-W, North 50' ±
  - Walking path running E-W, South 35'

P.A. 345 1990 KENT COUNTY  
PEER APPROVED 2/19/98  
CHAIRMAN Hans Huber

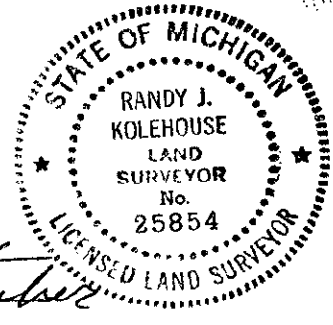

Signed by Randy J. Kolehouse Date 9-1-98  
EARTH TECH  
Surveyor's Michigan License No. 25854