

SURVEY & REMONUMENTATION

KENT COUNTY REMONUMENTATION

STATE OF MICHIGAN
COUNTY OF KENT
RECEIVED FOR RECORD

MAR 03 1998

LAND CORNER RECORDATION CERTIFICATE
Filing Requirement of Act 74, Mich. P.A. 1970

97 APR 29 AM 8:28

For corners in **SECTION**
KENT COUNTY

Located In: Corner Code #

- | | | |
|------------------------------------|-------------------------|-------|
| 1. Public Land Survey | T <u>7N</u> R <u>9W</u> | K-13 |
| | T _____ R _____ | _____ |
| | T _____ R _____ | _____ |
| | T _____ R _____ | _____ |
| 2. Property Controlling in Section | S _____ T _____ R _____ | _____ |
| | S _____ T _____ R _____ | _____ |
| 3. Miscellaneous Property in Sec. | S _____ T _____ R _____ | _____ |
| | S _____ T _____ R _____ | _____ |

W. J. Bond
REG. OF DEEDS

9907

Register of Deeds Stamp & File Number

4. Lot No. _____, Recorded Plat _____
5. Private Claims _____

I, Kirk Breitels, in a field survey on Jan. 14, 1997 do hereby state that under requirements of P.A. 74, Michigan P.A. of 1970, the corner points mentioned in lines 1 and 2 above were in conformance with regulations and rules therefore as required in the current manual of survey instructions of the United States Department of the Interior, Bureau of Land Management or by a decree of a Court of Law and for that the corner points mentioned in lines 3, 4 and 5 above were in conformance with the rules of the Michigan Board of Land Surveyors or by a Decree of a Court of Law; established, re-established, monumented, recovered, found as expressed below:

NOTE: Not more than 2 corners, all in the same town and range, may be recorded on this certificate.

1	A	B	C	D	E	F	G	H	I	J	K	L	M
2		6		5		4		3		2		1	
3													
4		7		8		9		10		11		12	
5													
6		18		17		16		15		14		13	
7													
8		19		20		21		22		23		24	
9													
10		30		29		28		27		26		25	
11													
12		31		32		33		34		35		36	
13													

A. Description of original monument and accessories and/or subsequent restoration:

K-13	GL0	Lyon	Set Post
1976	LCRC #978	Bonnema	Set Capped Iron
1981	LCRC #1995	Jonker	Set Kent County Monument
1995	LCRC #8265	Byl	Kent County Monument

The position of this corner was previously approved by the Kent County Remonumentation Peer Group, monumented by Robert J. Jonker on 8/13/81 and was recorded per LCRC #1995

B. Description of corner evidence found and/or method applied in restoring or reestablishing corner:


K-13 Found standard Kent Co. Mon. (Harrison) per witnesses from above LCRC as set by Robert J. Jonker in place of the Capped Iron he found. Said Capped Iron checks with LCRC #978.

<u>LCRC #1995</u>	<u>LCRC #8265</u>		
Remon. tag 12" Oak	N39°E 29.74'	Nail & tag 16" Oak	N39°E 29.77'
Remon. tag 8" Walnut	S34°E 23.01'	Nail & tag 12" Walnut	S34°E 23.02'
Remon. tag Tri. 12" Oak	S77°E 21.78'	Nail & tag Tri. 18" Oak	S77°E 21.78'
Remon. tag 16" Oak	S56°W 29.08'	Nail & tag 22" Oak	S56°W 29.16'
Plat Monument West 92.4'		K-1 T6N, R9W, (KC Mon.)	S90°W 92.40'

The selected location is accepted by me and is generally accepted by professional surveyors as the best available evidence of the position of the original corner.

C. Description of monument for corner and accessories established to perpetuate locating the position of the corner:

K-13 Standard Kent County Monument			
Nail & KC Remon. tag NW side 16" Oak	N39°E	29.77'	
Nail & KC Remon. tag NE side 12" Walnut	S34°E	23.02'	
Nail & KC Remon. tag S. side Tri. 18" Oak	N77°W	21.87'	
Nail & KC Remon. tag SE side 22" Oak	S56°W	29.16'	
K-1 T6N, R9W (Kent Co. Mon.)	S90°W	92.40'	
Corner is under E-W fence On line with traces of fence to North.			

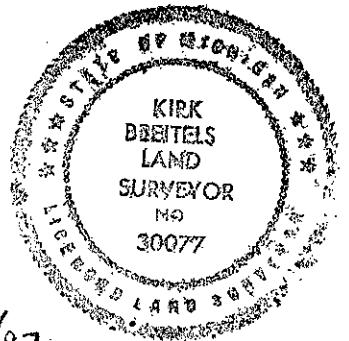

Signed by *Kirk Breitels*
Surveyor's Michigan License No. 30077

Date 3/27/97

P.A. 345 1990 KENT COUNTY
PEER APPROVED 3/27/97
CHAIRMAN *Harry Hubert*