

DEC 08 1989

\$7.00
\$2.00

LAND CORNER RECORDATION CERTIFICATE
Filing Requirement of Act 74, Mich. P.A. 1970
KENT COUNTY REMONUMENTATION

STATE OF MICHIGAN
COUNTY OF KENT
RECEIVED FOR RECORD
38 DEC 14 AM 8:00
REG. OF DEEDS
Lucy St. Grand

11036

Register of Deeds Stamp & File Number

For corners in

SECTION

Kent (County)	Located in: Vergennes Township	Corner Code #
1. Public Land Survey	T <u>7N</u> R <u>9W</u>	<u>L-1</u>
	T _____ R _____	_____
	T _____ R _____	_____
	T _____ R _____	_____
2. Property Controlling in Section	S _____ T _____ R _____	_____
	S _____ T _____ R _____	_____
3. Miscellaneous Property in Sec.	S _____ T _____ R _____	_____
	S _____ T _____ R _____	_____
4. Lot No. _____, Recorded Plat _____		
5. Private Claims _____		

I, Randy Kolehouse, in a field survey on October 6 19 98, do hereby certify that under requirements of P.A. 74 Michigan P.A. of 1970, the corner points mentioned in lines 1 and 2 above were in conformance with regulations and rules therefore as required in the current manual of survey instructions of the United States Department of the Interior, Bureau of Land Management or by a decree of a Court of Law and/or that the corner points mentioned in lines 3, 4 and 5 above were in conformance with the rules of the Michigan Board of Land Surveyors or by a Decree of a Court of Law; established, re-established, monumented, re-monumented, recovered, found as expressed below:

NOTE: Not more than 4 corners, all in the same town and range, may be recorded on this certificate.

A. Description of original monument and accessories and/or subsequent restoration:

L-1	Description	K.C. Surveyor	Material
	This corner was not originally set by the G.L.O.		
	1962 Witness Map	K.C. Surveyor	3/4" Iron
	1981 L.C.R.C. #2314	Nederveld & Jonker	Set 3/4" Iron at Midpoint
	1985 L.C.R.C. #4360	R. Kolehouse	Fnd. 3/4" Iron / Set K.C. Monument
	1991 L.C.R.C. #5920	William Byl	Set K.C. Monument

Note: This corner is not common with L-13, T8N, R9W.

This corner was originally approved by the Kent County Remonumentation Peer Group and monumented by Randy Kolehouse on 11/23/85 and was recorded per L.C.R.C. #4360.

B. Description of corner evidence found and/or method applied in restoring or reestablishing corner:

L-1 Found a Standard Kent County Monument 6.0' South of the C/L of 4 Mile Road (gravel) running East and West and 9.0' East of the C/L of Park Drive (gravel) running South per L.C.R.C.'s #4360 and #5920 as set by Randy Kolehouse in place of a 3/4" iron he found on line between the South 1/4 corner and the SE corner of Sec. 36, T8N, R9W which checked L.C.R.C. #2314 and the K.C. Surveyor's records.

L.C.R.C. #4360

L.C.R.C. #5920

Nail & K.C. Remon. tag in S. Side 8" Oak N 75° E 98.15'
 Nail & K.C. Remon. tag in E. side P. Pole S 15° E 91.76'
 Nail & K.C. Remon. tag in NW side P. Pole S 35° W 105.95'
 Nail & K.C. Remon. tag in N. side 16" Oak S 80° W 99.18'
 Nail & K.C. Remon. tag in N. side 36" Oak N 70° W 92.24'

Nail & KC Remon. tag S. side 10" Sassafras N 75° E 98.19' (m. 98.06')
 Nail & KC Remon. tag E. side Tel. Pole S 15° E 91.79' (m. 91.77')
 Nail & KC Remon. tag NW side P. Pole S 35° W 105.95' (m. 105.94')
 Nail & KC Remon. tag S. side 30" Oak S 80° W 99.79' (m. 99.64')
 Nail & KC Remon. tag N. side 42" Oak N 70° W 92.28' (m. 92.17')
 KC Monument @ S 1/4 cor. Sec. 36, T8N, R9W S 90° W 12.52' (m. 12.57')

The selected location is accepted by me and is generally accepted by professional surveyors as the best available evidence of the position of the original corner.

C. Description of monument for corner and accessories established to perpetuate locating the position of the corner:

L-1 Standard Kent County Monument

Nail & K.C. remon. tag on S side 10" Sassafras N 75° E 98.06'
 Nail & K.C. remon. tag on E side Tele. Pole S 15° E 91.77'
 Nail & K.C. remon. tag on NW side P. pole S 35° W 105.94'
 Nail & K.C. remon. tag on S side 30" Oak S 80° W 99.64'
 Nail & K.C. remon. tag on N side 42" Oak N 70° W 92.17'


C/L of gravel road running E-W, North 6.0'
 C/L of gravel road running S, West 9.0'
 K.C. Mon., L-13, T8N, R9W, S 90° W 12.57'

Signed by


Randy J. Kolehouse
EARTH TECH

Surveyor's Michigan License No.

25854

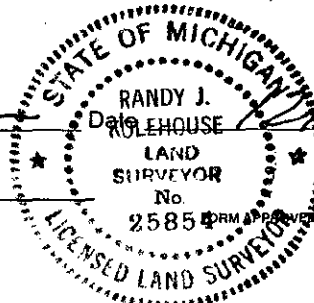

12/4/98

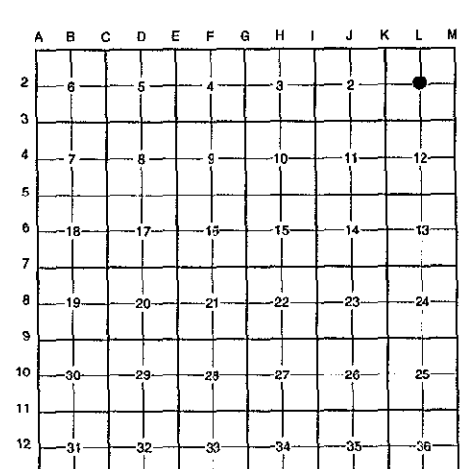

P.A. 345 1990 KENT COUNTY
PEER APPROVED 9/20/98
CHAIRMAN *Randy Kolehouse*