

\$7.00
\$2.00

REVENUE & RECORDS DIVISION

MAR 08 1999

SECTION

LAND CORNER RECORDATION CERTIFICATE
Filing Requirement of Act 74, Mich. P.A. 1970
KENT COUNTY REMONUMENTATION

For corners in


Kent (County)	Located in:	Vergennes Township	Corner Code #
1. Public Land Survey	T <u>7N</u>	R <u>9W</u>	<u>L-2</u>
	T _____	R _____	_____
	T _____	R _____	_____
	T _____	R _____	_____
2. Property Controlling in Section	S _____	T _____	R _____
	S _____	T _____	R _____
3. Miscellaneous Property in Sec.	S _____	T _____	R _____
	S _____	T _____	R _____

STATE OF MICHIGAN
COUNTY OF KENT
RECEIVED FOR RECORD
98 DEC 14 AM 8:00
REG. OF DEEDS
Lucy Stand

10947

Register of Deeds Stamp & File Number

- 4. Lot No. _____, Recorded Plat _____
- 5. Private Claims _____

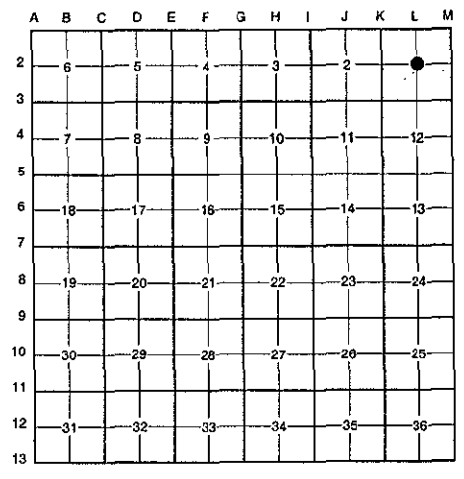

I, Randy Kolehouse, in a field survey on January 7 19 98, do hereby certify that under requirements of P.A. 74 Michigan P.A. of 1970, the corner points mentioned in lines 1 and 2 above were in conformance with regulations and rules therefore as required in the current manual of survey instructions of the United States Department of the interior, Bureau of Land Management or by a decree of a Court of Law and/or that the corner points mentioned in lines 3, 4 and 5 above were in conformance with the rules of the Michigan Board of Land Surveyors or by a Decree of a Court of Law; established, re-established, monumented, re-monumented, recovered, found as expressed below:

NOTE: Not more than 4 corners, all in the same town and range, may be recorded on this certificate.

A. Description of original monument and accessories and/or subsequent restoration:

L-2	Description	Year	Survey	Surveyor	Monument
	This corner was not originally set by the G.L.O.				
		1979	L.C.R.C. #2314	Nederveld & Jonker	Set Iron at Int. of 1/4 Lines
		1979	Cert. Survey L. 101 P. 15	Nederveld & Jonker	Capped Rerop
		1985	Cert. Survey L. 196 P. 42	Nederveld Associates	1-1/4" Iron
		1993	Cert. Survey L. 258 P. 2	Exxel Engineering	1/2" Iron Pipe

P.A. 345 1990 KENT COUNTY
PEER APPROVED 9/24/98
CHAIRMAN *[Signature]*

B. Description of corner evidence found and/or method applied in restoring or reestablishing corner:


L-2 Found a 1-1/2" iron pipe as set by Nederveld at the intersection of 1/4 lines in 1979 14.0' East of the C/L of Fallsburg Park Road (gravel) running North and South and .8' below grade per L.C.R.C. #2314 and Cert. Surveys L. 101 P. 15, L. 196 P. 42 and L. 258 P. Iron pipe is 0.1' East and 0.2' South of the intersection of 1/4 lines. Accepted iron as Center of Section.

Cert. Survey L. 258 P. 2	L.C.R.C. #2314
Nail & tag in E sde 28" Oak S-SE 44.66'	Spike on E. side 22" Oak SSE 44.94' (m. 44.68')
Nail & tag in S sde 18" Walnut W-NW 34.56'	Spike on W side 12" Sassafras NNE 34.81' (m. 35.16')
Nail & tag in NW sde 16" Sassafras N-NE 35.15	Spike on S side 12" Sassafras W-WNW 34.4' (m. 34.56')

The selected location is accepted by me and is generally accepted by professional surveyors as the best available evidence of the position of the original corner.

C. Description of monument for corner and accessories established to perpetuate locating the position of the corner:

- L-2 Replaced Iron Pipe with a Standard Kent County Monument
- Nail & K.C. remon. tag on E side 28" Oak S 20° E 44.68'
- Nail & K.C. remon. tag on S side 18" Walnut N 70° W 34.56'
- Nail & K.C. remon. tag on NW side 16" Sassafras N 30° E 35.16'
- Nail & K.C. remon. tag on N side 14" Oak S 60° W 43.14'
- Nail & K.C. remon. tag on E side 16" Oak N 15° E 54.58'
- Rebar due West 33.00'
- C/L of gravel road running N-S, West 14.0'

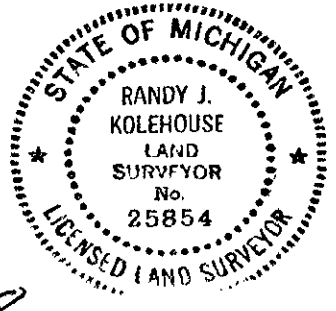

Signed by *Randy J. Kolehouse* Date 11/18/98
EARTH TECH

Surveyor's Michigan License No. 25854