

County of Kent
 REMONUMENTATION
 \$7.00
 \$2.00
 FEB 08 1999

STATE OF MICHIGAN
 COUNTY OF KENT
 RECEIVED FOR RECORD
 98 OCT 23 AM 9:58
 REG. OF DEEDS
Tim Standa

LAND CORNER RECORDATION CERTIFICATE
 Filing Requirement of Act 74, Mich. P.A. 1970
 KENT COUNTY REMONUMENTATION


For corners in SECTION

Kent (County)	Located in: Vergennes Township	Corner Code #
1. Public Land Survey	T <u>7N</u> R <u>9W</u>	<u>L-3</u>
	T _____ R _____	_____
	T _____ R _____	_____
	T _____ R _____	_____
2. Property Controlling in Section	S _____ T _____ R _____	_____
	S _____ T _____ R _____	_____
3. Miscellaneous Property in Sec.	S _____ T _____ R _____	_____
	S _____ T _____ R _____	_____

10813
 Register of Deeds Stamp & File Number

4. Lot No. _____, Recorded Plat _____
 5. Private Claims _____

I, Randy Kolehouse, in a field survey on January 7 19 98, do hereby certify that under requirements of P.A. 74 Michigan P.A. of 1970, the corner points mentioned in lines 1 and 2 above were in conformance with regulations and rules therefore as required in the current manual of survey instructions of the United States Department of the interior, Bureau of Land Management or by a decree of a Court of Law and/or that the corner points mentioned in lines 3, 4 and 5 above were in conformance with the rules of the Michigan Board of Land Surveyors or by a Decree of a Court of Law; established, re-established, monumented, re-monumented, recovered, found as expressed below:

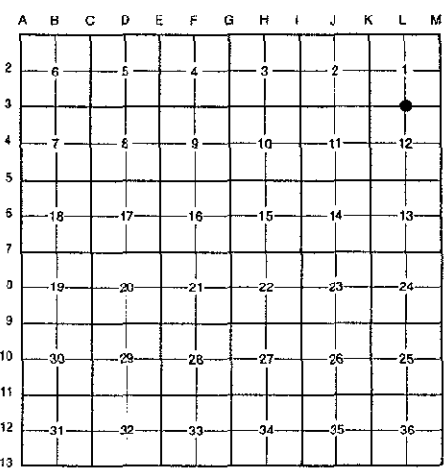

NOTE: Not more than 4 corners, all in the same town and range, may be recorded on this certificate.

A. Description of original monument and accessories and/or subsequent restoration:

L-3	1838	G.L.O. Notes	N. Brookfield	Set Post
	1938	Witness Map	K.C. Surveyor	Concrete Monument
	1986	L.C.R.C. #4472	T. Chettleburgh	Fnd. Concrete Monument / Set K.C. Monument
	1995	L.C.R.C. #8266	William Byl	K.C. Monument

This corner was originally approved by the Kent County Remonumentation Peer Group and monumented by T. Chettleburgh on 4/1/86 and was recorded per L.C.R.C. #4472.

B. Description of corner evidence found and/or method applied in restoring or reestablishing corner:

L-3 Found a Standard Kent County Monument 2' North and 3' West of the C/L intersection of 3 Mile Road (bit.) running East and Fallasburg Park Drive (bit.) running North and South per L.C.R.C.'s #4472 and #8266 as set by T. Chettleburgh in place of a concrete monument he found which checked the K.C. Surveyor's records.

L.C.R.C. #4472


L.C.R.C. #8266

Nail in SE side Power Pole N58°E 187.17'	Nail & KC Remon. tag SE side P. Pole N58°E 187.17' (m. 187.18')
Nail in North side 34" Hickory S85°W 169.44'	Nail & KC Remon. tag N. side 36" Hickory S85°W 169.44' (m. 169.47')
Nail in South side 34" Oak N81°W 158.38'	Nail & KC Remon. tag S. side 40" Oak N81°W 158.38'
Nail in North side 19" Hickory N70°W 76.65'	Nail & KC Remon. tag N. side 22" Hickory N70°W 76.69' (m. 76.71')
	W'ly corner MBT pedestal N80°E 27.90' (m. 27.84')

The selected location is accepted by me and is generally accepted by professional surveyors as the best available evidence of the position of the original corner.

C. Description of monument for corner and accessories established to perpetuate, locating the position of the corner:

L-3 Standard Kent County Monument
 Nail & K.C. remon. tag on SE side P. pole N 58° E 187.18'
 Nail & K.C. remon. tag on N side 36" Hickory S 85° W 169.47'
 Nail & K.C. remon. tag on S side 40" Oak N 81° W 158.38'
 Nail & K.C. remon. tag on N side 22" Hickory N 70° W 76.71'
 W'ly cor. MBT pedestal N 80° E 27.84'
 C/L "X" of bit. roads is 3' ± E and 2' ± South

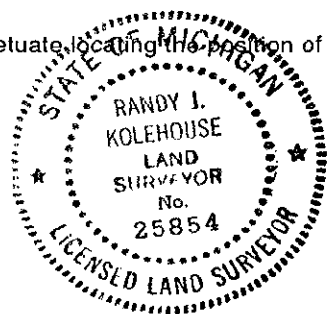

Signed by Randy J. Kolehouse Date 9-1-98
 EARTH TECH

Surveyor's Michigan License No. 25854