

DEC 03 1999

**LAND CORNER RECORDATION CERTIFICATE**  
**Filing Requirement of Act 74, Mich. P.A. 1970**  
**KENT COUNTY REMONUMENTATION**

SECTION \_\_\_\_\_

For corners in

Kent (County)	Located in: Township	Vergennes	Corner Code #
1. Public Land Survey	T <u>7N</u>	R <u>9W</u>	<u>L-4</u>
	T _____	R _____	_____
	T _____	R _____	_____
	T _____	R _____	_____
2. Property Controlling In Section	S _____	T _____	R _____
	S _____	T _____	R _____
3. Miscellaneous Property in Sec.	S _____	T _____	R _____
	S _____	T _____	R _____


STATE OF MICHIGAN  
 COUNTY OF KENT  
 RECEIVED FOR RECORD  
 38 DEC 14 AM 8:00  
 REG. OF DEEDS  
*Luigi Bond*

10948

Register of Deeds Stamp & File Number

4. Lot No. \_\_\_\_\_, Recorded Plat \_\_\_\_\_  
 5. Private Claims \_\_\_\_\_

I, Randy Kolehouse, in a field survey on January 7 19 98, do hereby certify that under requirements of P.A. 74 Michigan P.A. of 1970, the corner points mentioned in lines 1 and 2 above were in conformance with regulations and rules therefore as required in the current manual of survey instructions of the United States Department of the interior, Bureau of Land Management or by a decree of a Court of Law and/or that the corner points mentioned in lines 3, 4 and 5 above were in conformance with the rules of the Michigan Board of Land Surveyors or by a Decree of a Court of Law; established, re-established, monumented, re-monumented, recovered, found as expressed below:

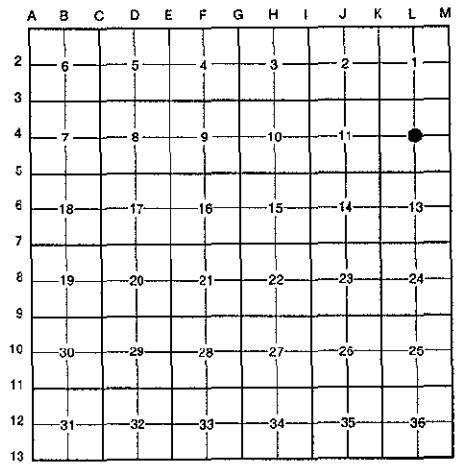

**NOTE: Not more than 4 corners, all in the same town and range, may be recorded on this certificate.**

- A. Description of original monument and accessories and/or subsequent restoration:  
 L-4 This corner was not originally set by the G.L.O.  
 No Information on Record for this Corner


P.A. 345 1990 KENT COUNTY  
 PEER APPROVED 10/22/98  
 CHAIRMAN *Randy J. Kolehouse*

- B. Description of corner evidence found and/or method applied in restoring or reestablishing corner:  
 L-4 Found a Nederveld capped iron as set by Nederveld & Associates at the intersection of 1/4 lines 2.0' West of the C/L of Fallsburg Park Road (bit.) running North and South. Iron is 1.5' North of the intersection of 1/4 lines. Accepted Nederveld iron as Center of Section.

The selected location is accepted by me and is generally accepted by professional surveyors as the best available evidence of the position of the original corner.

- C. Description of monument for corner and accessories established to perpetuate locating the position of the corner:  
 L-4 Replaced Capped Iron with a Standard Kent County Monument

- Nail & K.C. remon. tag on E side 15" Elm S 30° W 51.62'
- Nail & K.C. remon. tag on S side 40" Oak N 80° W 28.51'
- Nail & K.C. remon. tag on W side 40" Oak N 20° W 82.47"
- Nail & K.C. remon. tag on W side triple 18" Oak N 40° E 56.06'
- Nail & K.C. remon. tag on N side 16" Oak S 65° E 29.88'

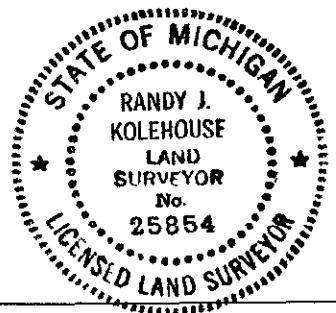

Signed by *Randy J. Kolehouse*  
 EARTH TECH

Date 1/18/98

Surveyor's Michigan License No. 25854