

**SURVEY &
REMONUMENTATION**

MAY 22 2000

**LAND CORNER RECORDATION CERTIFICATE
Filing Requirement of Act 74, Mich. P.A. 1970
KENT COUNTY REMONUMENTATION**

For corners in **SECTION**
Kent
(County)

Located in: Vergennes Corner Code #
Township

- | | | | | | |
|---------------------------------------|---|-----------|---|-----------|------------|
| 1. Public Land Survey | T | <u>7N</u> | R | <u>9W</u> | <u>L-4</u> |
| | T | _____ | R | _____ | _____ |
| | T | _____ | R | _____ | _____ |
| | T | _____ | R | _____ | _____ |
| 2. Property Controlling
in Section | S | _____ | T | _____ | _____ |
| | S | _____ | T | _____ | _____ |
| 3. Miscellaneous
Property in Sec. | S | _____ | T | _____ | _____ |
| | S | _____ | T | _____ | _____ |
4. Lot No. _____, Recorded Plat _____
5. Private Claims _____

Page 2

REG. OFFICERS


[Signature]

STATE OF MICHIGAN
COUNTY OF KENT
RECEIVED FOR RECORD
1999 DEC 30 AM 9:54

11692

Register of Deeds Stamp & File Number

I, Randy Kolehouse, in a field survey on December 29 19 99, do hereby certify that under requirements of P.A. 74 Michigan P.A. of 1970, the corner points mentioned in lines 1 and 2 above were in conformance with regulations and rules therefore as required in the current manual of survey instructions of the United States Department of the interior, Bureau of Land Management or by a decree of a Court of Law and/or that the corner points mentioned in lines 3, 4 and 5 above were in conformance with the rules of the Michigan Board of Land Surveyors or by a Decree of a Court of Law; established, re-established, monumented, re-monumented, recovered, found as expressed below:

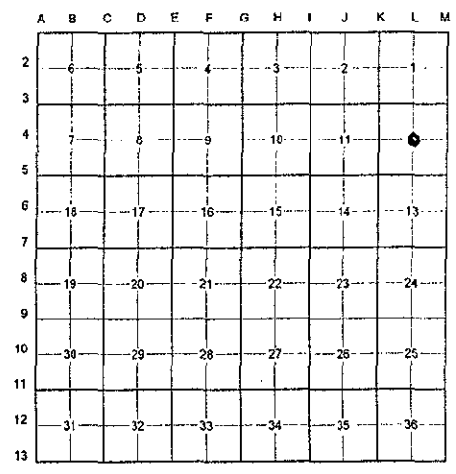

NOTE: Not more than 4 corners, all in the same town and range, may be recorded on this certificate.

A. Description of original monument and accessories and/or subsequent restoration:
L-4 This corner was not originally set by the G.L.O.
1999 L.C.R.C. #10948 Earth Tech Set K.C. Monument

This corner was originally approved by the Kent County Remonumentation Peer Group and monumented by Earth Tech on 1/7/98 and was recorded per L.C.R.C. #10948.

B. Description of corner evidence found and/or method applied in restoring or reestablishing corner:
L-4 Found a Standard Kent County Monument per L.C.R.C. #10948 witnesses as set by Earth Tech.

L.C.R.C. #10948


- Nail & K.C. remon. tag on E side 15" Elm S 30° W 51.62'
- Nail & K.C. remon. tag on S side 40" Oak N 80° W 28.51'
- Nail & K.C. remon. tag on W side 40" Oak N 20° W 82.47'
- Nail & K.C. remon. tag on W side triple 18" Oak N 40° E 56.06'
- Nail & K.C. remon. tag on N side 16" Oak S 65° E 29.88'

P.A. 345 1990 KENT COUNTY
PEER APPROVED 10/22/98
CHAIRMAN *[Signature]*

The selected location is accepted by me and is generally accepted by professional surveyors as the best available evidence of the position of the original corner.

C. Description of monument for corner and accessories established to perpetuate locating the position of the corner:
L-4 Reset a Standard Kent County Monument - Also Set a Monument Box

- Nail & K.C. remon. tag on E side 15" Elm S 30° W 51.62'
- Nail & K.C. remon. tag on S side 40" Oak N 80° W 28.51'
- Nail & K.C. remon. tag on W side 40" Oak N 20° W 82.47'
- Nail & K.C. remon. tag on W side triple 18" Oak N 40° E 56.06'
- Nail & K.C. remon. tag on N side 16" Oak S 65° E 29.88'

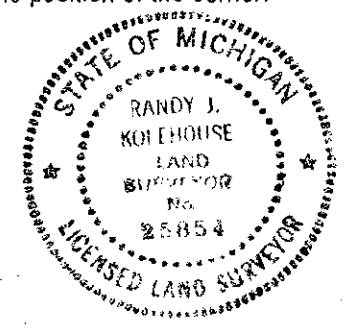

Signed by *Randy J. Kolehouse* Date 12-29-99
WILLIAMS & WORKS

Surveyor's Michigan License No. 25854