

MAR 08 1999

SECTION

LAND CORNER RECORDATION CERTIFICATE
Filing Requirement of Act 74, Mich. P.A. 1970
KENT COUNTY REMONUMENTATION

STATE OF MICHIGAN
COUNTY OF KENT
RECEIVED FOR RECORD
98 OCT 23 AM 9:58
REG. OF DEEDS

For corners in

Table with columns: Kent (County), Located in: Vergennes Township, Corner Code #. Rows include Public Land Survey, Property Controlling in Section, Miscellaneous Property in Sec.

10815

Register of Deeds Stamp & File Number


- 4. Lot No. \_\_\_\_\_, Recorded Plat \_\_\_\_\_
5. Private Claims \_\_\_\_\_

I, Randy Kolehouse, in a field survey on January 14 19 98, do hereby certify that under requirements of P.A. 74 Michigan P.A. of 1970, the corner points mentioned in lines 1 and 2 above were in conformance with regulations and rules therefore as required in the current manual of survey instructions of the United States Department of the interior, Bureau of Land Management or by a decree of a Court of Law and/or that the corner points mentioned in lines 3, 4 and 5 above were in conformance with the rules of the Michigan Board of Land Surveyors or by a Decree of a Court of Law; established, re-established, monumented, re-monumented, recovered, found as expressed below:

NOTE: Not more than 4 corners, all in the same town and range, may be recorded on this certificate.

A. Description of original monument and accessories and/or subsequent restoration:

Table with columns: L-7, 1838, G.L.O. Notes, N. Brookfield, Set Post. Rows include 1977, 1981, 1995 with details on L.C.R.C. notes and monument types.

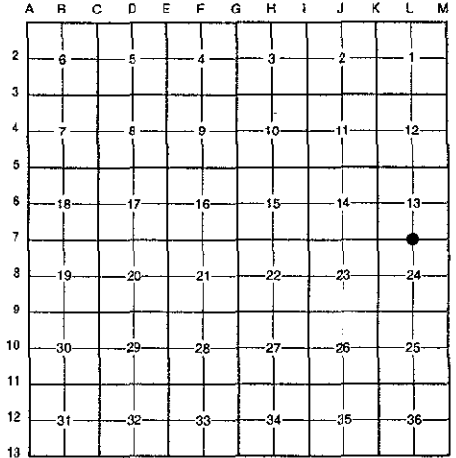

This corner was originally approved by the Kent County Remonumentation Peer Group and monumented by Rob Jonker on 8/11/81 and was recorded per L.C.R.C. #1996.

PEER APPROVED 2/19/98
CHAIRMAN Randy Kolehouse

B. Description of corner evidence found and/or method applied in restoring or reestablishing corner:


L-7 Found a Standard Kent County Monument on line of a tree row and fence line running South and East per L.C.R.C.'s #1996 and #1996 as set by Rob Jonker in place of a 1/2" iron he found by stones which checked L.C.R.C. #1072.

Table comparing L.C.R.C. #1996 and #8268. Columns: L.C.R.C. #1996, L.C.R.C. #8268. Rows: Remon. tag on SW side 11" Oak S62°E 5.76', Remon. tag on NW side 12" Oak N43°E 23.49', Remon. tag on E side 36" Oak S09°W 31.17', Remon. tag on S side 7" Oak N84°W 25.19'.

The selected location is accepted by me and is generally accepted by professional surveyors as the best available evidence of the position of the original corner.

C. Description of monument for corner and accessories established to perpetuate locating the position of the corner:

- L-7 Standard Kent County Monument
Nail & K.C. remon. tag on SW side 15" Oak S 62° E 5.78'
Nail & K.C. remon. tag on NW side 15" Oak N 43° E 23.53'
Nail & K.C. remon. tag on E side 40" Oak S 09° W 31.15'
Nail & K.C. remon. tag on S side 12" Oak N 84° W 25.19'
On "X" of tree row and fence line running S & E

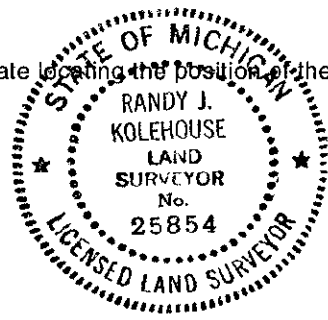

Signed by Randy J. Kolehouse Date 9-1-98
EARTH TECH
-Surveyor's Michigan License No. 25854