

SURVEY & REMONUMENTATION

MAR 08 1999

LAND CORNER RECORDATION CERTIFICATE  
Filing Requirement of Act 74, Mich. P.A. 1970  
KENT COUNTY REMONUMENTATION


STATE OF MICHIGAN  
COUNTY OF KENT  
RECEIVED FOR RECORD  
38 OCT 23 AM 9:58  
REG. OF DEEDS  
*Randy Kolehouse*

For corners in SECTION \_\_\_\_\_

Kent (County)	Located in: Vergennes Township	Corner Code #
1. Public Land Survey	T <u>7N</u> R <u>9W</u>	<u>L-11</u>
	T _____ R _____	_____
	T _____ R _____	_____
	T _____ R _____	_____
2. Property Controlling in Section	S _____ T _____ R _____	_____
	S _____ T _____ R _____	_____
3. Miscellaneous Property in Sec.	S _____ T _____ R _____	_____
	S _____ T _____ R _____	_____
4. Lot No. _____, Recorded Plat _____		
5. Private Claims _____		

10816  
Register of Deeds Stamp & File Number

I, Randy Kolehouse, in a field survey on January 14 19 98, do hereby certify that under requirements of P.A. 74 Michigan P.A. of 1970, the corner points mentioned in lines 1 and 2 above were in conformance with regulations and rules therefore as required in the current manual of survey instructions of the United States Department of the interior, Bureau of Land Management or by a decree of a Court of Law and/or that the corner points mentioned in lines 3, 4 and 5 above were in conformance with the rules of the Michigan Board of Land Surveyors or by a Decree of a Court of Law; established, re-established, monumented, re-monumented, recovered, found as expressed below:

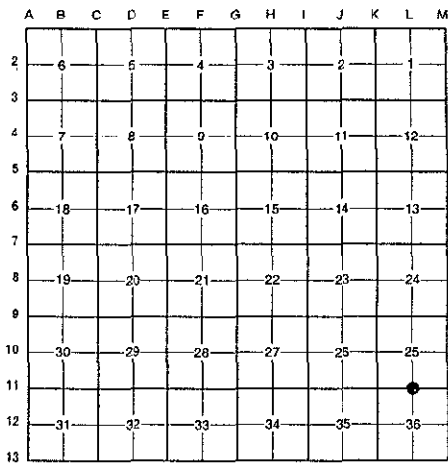

NOTE: Not more than 4 corners, all in the same town and range, may be recorded on this certificate.

A. Description of original monument and accessories and/or subsequent restoration:

L-11	1838	G.L.O. Notes	N. Brookfield	Set Post
	1977	L.C.R.C. #1862	C. Hay	Iron & Cap
	1981	L.C.R.C. #1997	Jonker Land Survey	Fnd. Iron & Cap / Set K.C. Monument
	1995	L.C.R.C. #8274	William Byl	K.C. Monument

P.A. 345 1990 KENT COUNTY  
PEER APPROVED 2/19/98  
CHAIRMAN Randy Kolehouse

This corner was originally approved by the Kent County Remonumentation Peer Group and monumented by Rob Jonker on 8/13/81 and was recorded per L.C.R.C. #1997.


B. Description of corner evidence found and/or method applied in restoring or reestablishing corner:  
L-11 Found a Standard Kent County Monument 15' North of a fence line running West and 5' West of a fence line running North and South per L.C.R.C.'s #1997 and #8274 as set by Rob Jonker in place of an iron and cap he found which checked L.C.R.C. #1862.

L.C.R.C. #1997	L.C.R.C. #8274
Remon. tag on S side 30" Oak S87°W 38.38'	Nail & KC Remon. tag S. side 32" Oak S87°W 38.37' (m. 38.41')
Remon. tag on SW side 12" Oak S56°E 51.46'	Nail & KC Remon. tag SW side 20" Oak S56°E 51.41' (m. 51.40')
Remon. tag on SE side 12" Poplar N60°E 22.70'	Nail & KC Remon. tag SE side 16" Poplar N60°E 23.07' (m. 23.05')
Remon. tag on E side 5" tw. Maple N28°W 25.67'	Nail & KC Remon. tag E. side Tw. 12" Maple N28°W 25.64' (m. 25.62')
	Nail & KC Remon. tag W. side 6" Oak S20°W 29.34' (m. 29.35')
	1" Iron Pipe S10°E 8.00'

The selected location is accepted by me and is generally accepted by professional surveyors as the best available evidence of the position of the original corner.

C. Description of monument for corner and accessories established to perpetuate locating the position of the corner:

- L-11 Standard Kent County Monument
- Nail & K.C. remon. tag on S side 24" Oak S 87° W 38.41'
  - Nail & K.C. remon. tag on SW side 20" Oak S 56° E 51.40'
  - Nail & K.C. remon. tag on SE side 16" Poplar N 60° E 23.05'
  - Nail & K.C. remon. tag on E side twin 12" Maple N 28° W 25.62'
  - Nail & K.C. remon. tag on W side 6" Oak S 20° W 29.35'
  - 1" Iron pipe S 10° E 8.00'
  - Fence line running W, South 15.0'
  - Fence line running N-S, East 5.0'

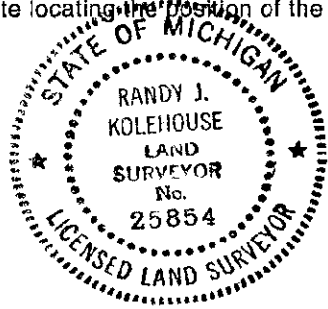

Signed by Randy J. Kolehouse Date 9-1-98

Surveyor's Michigan License No. 25854