

\$7.00 KENT COUNTY REMONUMENTATION
\$2.00
MAR 08 1999

LAND CORNER RECORDATION CERTIFICATE
Filing Requirement of Act 74, Mich. P.A. 1970
KENT COUNTY REMONUMENTATION

For corners in SECTION

For corners in	Located in:	Vergennes Township	Corner Code #
Kent (County)	T <u>7N</u>	R <u>9W</u>	<u>L-12</u>
1. Public Land Survey	T _____	R _____	_____
	T _____	R _____	_____
	T _____	R _____	_____
2. Property Controlling in Section	S _____	T _____	R _____
	S _____	T _____	R _____
3. Miscellaneous Property in Sec.	S _____	T _____	R _____
	S _____	T _____	R _____


STATE OF MICHIGAN
COUNTY OF KENT
RECEIVED FOR RECORD
38 DEC 14 AM 8:00
REG. OF DEEDS
Luis J. Bond

11040

Register of Deeds Stamp & File Number

4. Lot No. _____, Recorded Plat _____
5. Private Claims _____

I, Randy Kolehouse, in a field survey on January 9 19 98, do hereby certify that under requirements of P.A. 74 Michigan P.A. of 1970, the corner points mentioned in lines 1 and 2 above were in conformance with regulations and rules therefore as required in the current manual of survey instructions of the United States Department of the Interior, Bureau of Land Management or by a decree of a Court of Law and/or that the corner points mentioned in lines 3, 4 and 5 above were in conformance with the rules of the Michigan Board of Land Surveyors or by a Decree of a Court of Law; established, re-established, monumented, re-monumented, recovered, found as expressed below:

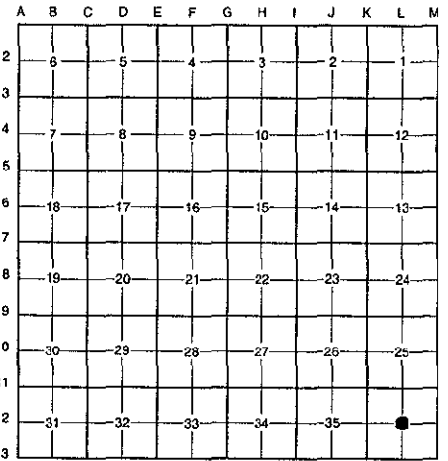

NOTE: Not more than 4 corners, all in the same town and range, may be recorded on this certificate.

A. Description of original monument and accessories and/or subsequent restoration:

L-12 This corner was not originally set by the G.L.O.
1990 Cert. Survey L. 218 P. 45 K. Roosien Rerod
1990 L.C.R.C. #5304 K. Roosien Set Capped Iron

P.A. 345 1990 KENT COUNTY
PEER APPROVED 12/3/98
CHAIRMAN *Harry Huber*

B. Description of corner evidence found and/or method applied in restoring or reestablishing corner:

L-12 Found a Roosien iron on old fence lines running North and West, 18' ± East of the C/L of a gravel driveway running NW, 10' ± East of the C/L of a gravel road running East, and 10' ± East of the C/L of a gravel road running South. Iron is 17.8' East and 2.9' North of the intersection of 1/4 lines. Accepted iron as Center of Section.

L.C.R.C. #5304

- Glaza iron West 33.00'
- Spike in W. side power pole N10°E 47.71' (m. 47.73')
- Spike in E. side 36" Twin Oak S15°E 10.53' (m. 10.50')

The selected location is accepted by me and is generally accepted by professional surveyors as the best available evidence of the position of the original corner.

C. Description of monument for corner and accessories established to perpetuate locating the position of the corner:

- L-12 Replaced Capped Iron with a Standard Kent County Monument
- Nail & K.C. remon. tag on W side P. pole W 10° E 47.73'
 - Nail & K.C. remon. tag on E side 36" Twin Oak S 15° E 10.50'
 - Nail & K.C. remon. tag on SW side 20" Oak S 30° W 61.22'
 - Nail & K.C. remon. tag on N side 12" Oak N 75° E 52.73'
 - Glaza iron West 33.0'
 - C/L of gravel road, SE 27.0'



Signed by *Randy J. Kolehouse* Date 12/5/98
EARTH TECH

Surveyor's Michigan License No. 25854