

**SURVEY & REMONUMENTATION**

**MAR 03 1998**

**KENT COUNTY REMONUMENTATION**

STATE OF MICHIGAN  
COUNTY OF KENT  
RECEIVED FOR RECORD

**LAND CORNER RECORDATION CERTIFICATE**  
Filing Requirement of Act 74, Mich. P.A. 1970

**97 APR 29 AM 8:28**

For corners in **SECTION**

**KENT COUNTY**

(County)

Located In:

Corner Code #

1. Public Land Survey

T 7N R 9W L-13

2. Property Controlling in Section

S T R

3. Miscellaneous Property in Sec.

S T R

*W. J. Bond*  
REG. OF DEEDS

**9908**

Register of Deeds Stamp & File Number

4. Lot No. \_\_\_\_\_, Recorded Plat \_\_\_\_\_

5. Private Claims \_\_\_\_\_

A	B	C	D	E	F	G	H	I	J	K	L	M
1												
2	6	5	4	3	2	1						
3												
4	7	8	9	10	11	12						
5												
6	18	17	16	15	14	13						
7												
8	19	20	21	22	23	24						
9												
10	30	29	28	27	26	25						
11												
12	31	32	33	34	35	36						
13												

I, Kirk Breitels, in a field survey on Jan. 14, 1997 do hereby state that under requirements of P.A. 74, Michigan P.A. of 1970, the corner points mentioned in lines 1 and 2 above were in conformance with regulations and rules therefore as required in the current manual of survey instructions of the United States Department of the Interior, Bureau of Land Management or by a decree of a Court of Law and/or that the corner points mentioned in lines 3, 4 and 5 above were in conformance with the rules of the Michigan Board of Land Surveyors or by a Decree of a Court of Law; established, re-established, monumented, recovered, found as expressed below:

NOTE: Not more than 2 corners, all in the same town and range, may be recorded on this certificate.

A. Description of original monument and accessories and/or subsequent restoration:

L-13	GLO	Lyon	Set Post
1983	LCRC #3295	Glaza	"T" Iron
1991	LCRC #5764	Chettleburgh	Set Kent County Monument on Twp. line midway between K-13 and M-13.
1995	LCRC #8275	Byl	Kent County Monument

The position of this corner was previously approved by the Kent County Remonumentation Peer Group, monumented by Thomas Chettleburgh on 3/5/91 and was recorded per LCRC #5764.


B. Description of corner evidence found and/or method applied in restoring or reestablishing corner:

L-13 Found standard Kent Co. Mon. (Harrison) per witnesses from above LCRC as set by Thomas M. Chettleburgh.	LCRC #5764	L-1, 6-9, KC Mon. West 48.78'	LCRC #8275	L-1, 6-9 (KC Mon.) West 48.78'
Remon. tag 24" Walnut	S76°E	21.43'	Nail & tag 24" Walnut	S76°E 21.43'
Remon. tag P. Pole	S44°E	59.00'	Nail & tag P. Pole	S44°E 58.88'
Remon. tag P. Pole	S69°W	102.12'	Nail & tag 16" Maple	N88°W 28.92'
Remon. tag 16" Maple	N88°W	28.87'	Nail & tag 10" Oak	N08°W 62.13'
Remon. tag P. Pole	N76°W	95.38'	Nail & tag P. Pole	S50°E 47.51'
Remon. tag 10" Oak	N08°W	62.26'	Nail & tag P. Pole	S80°W 99.74'

The selected location is accepted by me and is generally accepted by professional surveyors as the best available evidence of the position of the original corner.

C. Description of monument for corner and accessories established to perpetuate locating the position of the corner:

L-13 Standard Kent County Monument		
Nail & KC Remon. tag N. side 26" Walnut	S76°E	21.43'
Nail & KC Remon. tag NE side P. Pole	S44°E	58.88'
Nail & KC Remon. tag N. side 18" Maple	N88°W	28.92'
Nail & KC Remon. tag W. side 14" Oak	N08°W	62.33'
Nail & KC Remon. tag NE side P. Pole	S50°E	47.51'
Nail & KC Remon. tag N. side P. Pole	S80°W	99.74'
L-1 (T6N, R9W - Kent Co. Mon.)	West	48.69'
E. edge of pavement is W. 36.2' m/l		

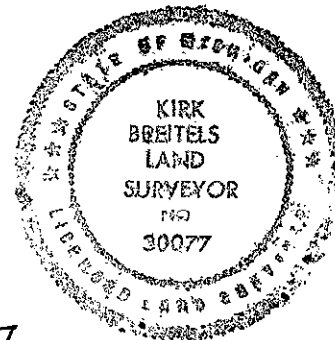

Signed by *Kirk Breitels*

Date 3/27/97

Surveyor's Michigan License No. 30077

P.A. 345 1990 KENT COUNTY

PEER APPROVED 3/27/97  
CHAIRMAN *Harry Kubeck*