

REMONUMENTATION  
 \$7.00  
 \$2.00  
 MAR 08 1999

**LAND CORNER RECORDATION CERTIFICATE**  
 Filing Requirement of Act 74, Mich. P.A. 1970  
 KENT COUNTY REMONUMENTATION


For corners in SECTION

Kent (County)	Located in: Vergennes Township	Corner Code #
1. Public Land Survey	T <u>7N</u> R <u>9W</u>	<u>M-1</u>
	T _____ R _____	_____
	T _____ R _____	_____
	T _____ R _____	_____
2. Property Controlling in Section	S _____ T _____ R _____	_____
	S _____ T _____ R _____	_____
3. Miscellaneous Property in Sec.	S _____ T _____ R _____	_____
	S _____ T _____ R _____	_____

STATE OF MICHIGAN  
 COUNTY OF KENT  
 RECEIVED FOR RECORD  
 38 OCT 23 AM 9:58  
 REG. OF DEEDS  
*[Signature]*

**10817**  
 Register of Deeds Stamp & File Number

4. Lot No. \_\_\_\_\_, Recorded Plat \_\_\_\_\_  
 5. Private Claims \_\_\_\_\_

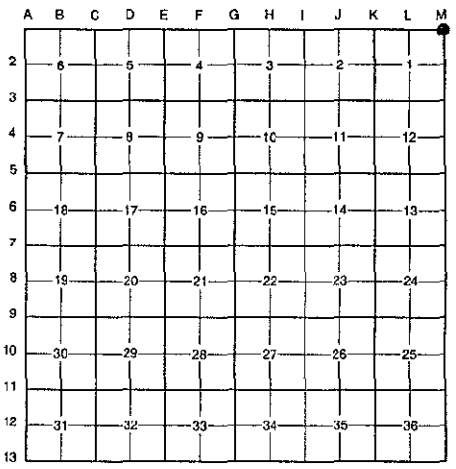

I, Randy Kolehouse, in a field survey on January 9 19 98, do hereby certify that under requirements of P.A. 74 Michigan P.A. of 1970, the corner points mentioned in lines 1 and 2 above were in conformance with regulations and rules therefore as required in the current manual of survey instructions of the United States Department of the interior, Bureau of Land Management or by a decree of a Court of Law and/or that the corner points mentioned in lines 3, 4 and 5 above were in conformance with the rules of the Michigan Board of Land Surveyors or by a Decree of a Court of Law; established, re-established, monumented, re-monumented, recovered, found as expressed below:

**NOTE: Not more than 4 corners, all in the same town and range, may be recorded on this certificate.**

**A. Description of original monument and accessories and/or subsequent restoration:**

M-1	1837	G.L.O. Notes	N. Brookfield	Set Post
	1932	Witness Map	K.C. Surveyor	1" Iron
	1978	L.C.R.C. #1133	Medema, Van Kooten & Assoc.	"T" Iron (M-13, T8N, R9W)
	1981	L.C.R.C. #1682	Williams & Works	Fnd. "T" Iron & Stone / Set K.C. Mon. (M-13, T8N, R9W)
	1991	L.C.R.C. #5915	William Byl	K.C. Monument (M-13, T8N, R9W)

Note: This corner is common with M-13, T8N, R9W; A-1, T7N, R8W; and A-13, T8N, R8W

This corner was originally approved by the Kent County Remonumentation Peer Group and monumented by Williams & Works on 4/14/98 and was recorded per L.C.R.C. #1682.

**B. Description of corner evidence found and/or method applied in restoring or reestablishing corner:**

M-1 Found a Standard Kent County Monument 12' ± North of the C/L intersection of 4 Mile Road (gravel) running East and West and Montcalm Road (gravel) running North, on line of a tree row and fence line running South, per L.C.R.C.'s #1682 and #5915 as set by Williams & Works in place of a bent "T" iron and pointed stone they found in a ring of smaller stones which checked L.C.R.C. #1133 and the K.C. Surveyor's records.

L.C.R.C. #1682

L.C.R.C. #5915

K.C. Remon. tag and nail in SE side 40" Oak N.50°E. 39.21'	KC Remon. tag & nail SE side 42" Oak N50°E 39.19' (m. 39.20')
K.C. Remon. tag and nail in S side 32" Hickory N.85°E. 53.26'	KC Remon. tag & nail S. side 36" Hickory N85°E 53.26' (m. 53.28')
K.C. Remon. tag and nail in NE side 28" Walnut N.55°W. 51.46'	KC Remon. tag & nail NE side 28" Walnut N55°W 51.39' (m. 51.42')
K.C. Remon. tag and nail in SE side 10" Ash S.40°W. 50.27'	KC Remon. tag & nail SE side 12" Ash S40°W 50.25' (m. 50.29')
K.C. Remon. tag and nail in W side 8" Maple S.15°W. 49.85'	K.C. Remon. tag & nail W. side 10" Maple S15°W 49.84' (m. 49.83') Steel bar & cap (#21272)

The selected location is accepted by me and is generally accepted by professional surveyors as the best available evidence of the position of the original corner.

**C. Description of monument for corner and accessories established to perpetuate locating the position of the corner:**

M-1 Standard Kent County Monument

Nail & K.C. remon. tag on SE side 42" Oak N 50° E 39.20'	C/L gravel road running E-W, North 12' ±
Nail & K.C. remon. tag on S side 36" Hickory N 85° E 53.28'	On C/L gravel road running N
Nail & K.C. remon. tag on NE side 28" Walnut N 55° W 51.42'	On tree row and fence line running S
Nail & K.C. remon. tag on SE side 12" Ash S 40° W 50.29'	
Nail & K.C. remon. tag on W side 10" Maple S 15° W 49.83'	

Signed by Randy J Kolehouse Date \_\_\_\_\_  
 EARTH TECH

Surveyor's Michigan License No. 25854

P.A. 345 1990 KENT COUNTY

PEER APPROVED 2/19/98  
 CHAIRMAN [Signature]

