

DAR 08 1999

\$7.00
\$2.00

SECTION

LAND CORNER RECORDATION CERTIFICATE

Filing Requirement of Act 74, Mich. P.A. 1970

KENT COUNTY REMONUMENTATION

For corners in

Kent (County)	Located in: Vergennes Township	Corner Code #
1. Public Land Survey	T <u>7N</u> R <u>9W</u>	<u>M-2</u>
	T _____ R _____	_____
	T _____ R _____	_____
	T _____ R _____	_____
2. Property Controlling in Section	S _____ T _____ R _____	_____
	S _____ T _____ R _____	_____
3. Miscellaneous Property in Sec.	S _____ T _____ R _____	_____
	S _____ T _____ R _____	_____

STATE OF MICHIGAN
COUNTY OF KENT
RECEIVED FOR RECORD

98 OCT 23 AM 9:58

REG. OF DEEDS
Eric Spauld


10818

Register of Deeds Stamp & File Number

- 4. Lot No. _____, Recorded Plat _____
- 5. Private Claims _____

I, Randy Kolehouse, in a field survey on January 14 19 98, do hereby certify that under requirements of P.A. 74 Michigan P.A. of 1970, the corner points mentioned in lines 1 and 2 above were in conformance with regulations and rules therefore as required in the current manual of survey instructions of the United States Department of the interior, Bureau of Land Management or by a decree of a Court of Law and/or that the corner points mentioned in lines 3, 4 and 5 above were in conformance with the rules of the Michigan Board of Land Surveyors or by a Decree of a Court of Law; established, re-established, monumented, re-monumented, recovered, found as expressed below:

NOTE: Not more than 4 corners, all in the same town and range, may be recorded on this certificate.

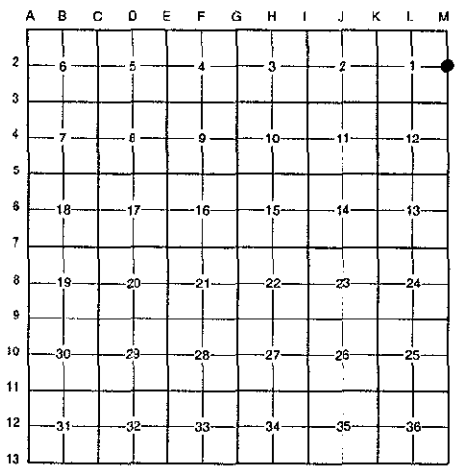

A. Description of original monument and accessories and/or subsequent restoration:

M-2	1837	G.L.O. Notes	N. Brookfield	Set Post
	1982	L.C.R.C. #2313	Nederveld & Jonker	2" Round Pipe
	1982	L.C.R.C. #3085	Williams & Works	2" Iron
	1990	L.C.R.C. #5312	T. Chettleburgh	Fnd. 1-1/4" Iron Pipe / Set K.C. Monument
	1995	L.C.R.C. #8276	William Byl	K.C. Monument

P.A. 345 1990 KENT COUNTY
PEER APPROVED 2/19/98
CHAIRMAN *Randy Kolehouse*

Note: This corner is common with A-2, T7N, R8W.
This corner was originally approved by the Kent County Remonumentation Peer Group and monumented by T. Chettleburgh on 1/31/90 and was recorded per L.C.R.C. #5312.

B. Description of corner evidence found and/or method applied in restoring or reestablishing corner:
M-2 Found a Standard Kent County Monument on line of a tree row running North and a fence line running East and West per L.C.R.C.'s #5312 and #8276 as set by T. Chettleburgh in place of a 1-1/4" iron pipe he found in the roots of a 36" Ash which checked L.C.R.C.'s #3085 and #2313.

L.C.R.C. #5312	L.C.R.C. #8276
Nail & KC Remon tag in S. side of 36" Ash N00°E 0.54'	Nail & KC Remon. tag S. side 40" Ash N00°E 0.54'
Nail & KC Remon tag in N. side of 7" Oak S70°E 36.80'	Nail & KC Remon. tag N. side 10" Oak S70°E 36.77' (m. 36.87')
Nail & KC Remon tag in NE side of 9" Oak S40°E 27.82'	Nail & KC Remon. tag NE side 12" Oak S40°E 27.82' (m. 27.85')
Nail & KC Remon tag in SE side of 5" Oak S76°W 30.04'	Nail & KC Remon. tag SE side 8" Oak S76°W 30.04'
Nail & KC Remon tag in SW side of 10" Oak N60°W 43.11'	Nail & KC Remon. tag SW side 12" Oak N60°W 43.17' (m. 43.16')
	Nail & KC Remon. tag W. side Tw. 6" Oak S05°W 32.06' (m. 31.11')

The selected location is accepted by me and is generally accepted by professional surveyors as the best available evidence of the position of the original corner.

C. Description of monument for corner and accessories established to perpetuate locating the position of the corner:
M-2 Standard Kent County Monument
Nail & K.C. remon. tag on S side 40" Ash N 00° E 0.54'
Nail & K.C. remon. tag on N side 10" Oak S 70° E 36.87'
Nail & K.C. remon. tag on NE side 12" Oak S 40° E 27.85'
Nail & K.C. remon. tag on SE side 8" Oak S 76° W 30.04'
Nail & K.C. remon. tag on SW side 12" Oak N 60° W 43.16'

Nail & K.C. remon. tag on W side twin 6" Oak S 05° W 32.11'
On tree row running N
On fence line running E-W

Signed by *Randy J. Kolehouse*
EARTH TECH
Surveyor's Michigan License No. 25854

