

MAR 08 1999

\$7.00
\$2.00

SECTION

LAND CORNER RECORDATION CERTIFICATE
Filing Requirement of Act 74, Mich. P.A. 1970
KENT COUNTY REMONUMENTATION

STATE OF MICHIGAN
COUNTY OF KENT
RECEIVED FOR RECORD
98 DEC 14 AM 8:00
REG. OF DEEDS
Lucy St. Paul

For corners in

Kent (County)	Located in:	Vergennes Township	Corner Code #
1. Public Land Survey	T <u>7N</u>	R <u>9W</u>	<u>M-4</u>
	T _____	R _____	_____
	T _____	R _____	_____
	T _____	R _____	_____
2. Property Controlling in Section	S _____	T _____	R _____
	S _____	T _____	R _____
3. Miscellaneous Property in Sec.	S _____	T _____	R _____
	S _____	T _____	R _____

10950

Register of Deeds Stamp & File Number

4. Lot No. _____, Recorded Plat _____
5. Private Claims _____

I, Randy Kolehouse, in a field survey on September 8 19 98, do hereby certify that under requirements of P.A. 74 Michigan P.A. of 1970, the corner points mentioned in lines 1 and 2 above were in conformance with regulations and rules therefore as required in the current manual of survey instructions of the United States Department of the interior, Bureau of Land Management or by a decree of a Court of Law and/or that the corner points mentioned in lines 3, 4 and 5 above were in conformance with the rules of the Michigan Board of Land Surveyors or by a Decree of a Court of Law; established, re-established, monumented, re-monumented, recovered, found as expressed below:

NOTE: Not more than 4 corners, all in the same town and range, may be recorded on this certificate.

A. Description of original monument and accessories and/or subsequent restoration:

M-4	1837	G.L.O. Notes	N. Brookfield	Set Post
	1990	L.C.R.C. #5314	T. Chettleburgh	Set K.C. Monument
	1995	L.C.R.C. #8278	William Byl	K.C. Monument

Note: This corner is common with A-4, T7N, R8W.

This corner was originally approved by the Kent County Remonumentation Peer Group and monumented by T. Chettleburgh on 2/9/98 and was recorded per L.C.R.C. #5314.

B. Description of corner evidence found and/or method applied in restoring or reestablishing corner:

M-4 Found a Standard Kent County Monument in woods per L.C.R.C.'s #5314 and #8278 as set by T. Chettleburgh by single proportionate measure between M-3 and M-5. No occupation lines were visible. Meas. North 2665.78' to M-3. Meas. South 2666.02' to M-5.

L.C.R.C. #5314

- Nail & KC Remon tag in W. side of 15" Wild Cherry N 12° E 34.00'
- Nail & KC Remon tag in NW side of 6" W. Oak N 36° E 28.64'
- Nail & KC Remon tag in NE side of 15" W. Oak S 69° E 21.14'
- Nail & KC Remon tag in NE side of 17" W. Oak S 18° E 13.94'
- Nail & KC Remon tag in W. side of 23" B. Oak S 16° W 30.02'
- Nail & KC Romon tag in N. side of 16" W. Oak N 79° W 37.13'

L.C.R.C. #8278


- Nail & KC Remon tag in W. side of 15" Wild Cherry N 12° E 34.02' (m. 33.99')
- Nail & KC Remon tag in NW side of 6" W. Oak N 36° E 28.64' (m. 28.5')
- Nail & KC Remon tag in NE side of 15" W. Oak S 69° E 21.18' (m. 21.17')
- Nail & KC Remon tag in NE side of 17" W. Oak S 18° E 13.97' (m. 13.97')
- Nail & KC Remon tag in W. side of 23" B. Oak S 16° W 30.04' (m. 30.02')
- Nail & KC Remon tag in N. side of 16" W. Oak N 79° W 37.13' (m. 37.15')

The selected location is accepted by me and is generally accepted by professional surveyors as the best available evidence of the position of the original corner.

C. Description of monument for corner and accessories established to perpetuate locating the position of the corner:

M-4 Standard Kent County Monument


- Nail & K.C. remon tag on W. side of 15" Wild Cherry N 11° E 33.99'
- Nail & K.C. remon tag on NW side of 6" W. Oak N 35° E 28.5'
- Nail & K.C. remon tag on NE side of 15" W. Oak S 70° E 21.17'
- Nail & K.C. remon tag on NE side of 17" W. Oak S 16° E 13.97'
- Nail & K.C. remon tag on W. side of 23" B. Oak S 19° W 30.02'
- Nail & K.C. remon tag on N. side of 16" W. Oak N 78° W 37.15'

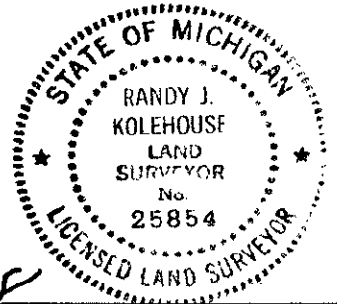

Signed by *Randy Kolehouse*
EARTH TECH

Date 11/18/98

Surveyor's Michigan License No. 25854

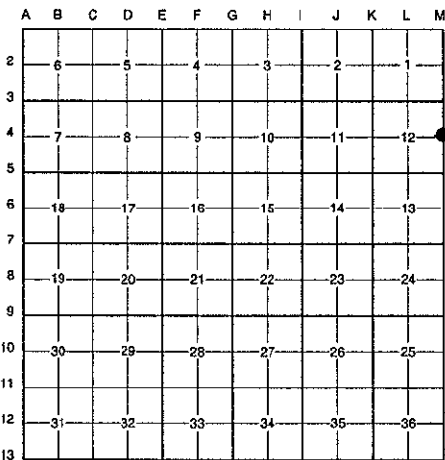

P.A. 345 1990 KENT COUNTY
PEER APPROVED 9/24/98
CHAIRMAN *Harry Tubel*