

\$7.00
\$2.00

PROPERTY &
RECORDS DIVISION

MAR 08 1999

LAND CORNER RECORDATION CERTIFICATE
Filing Requirement of Act 74, Mich. P.A. 1970
KENT COUNTY REMONUMENTATION

SECTION


For corners in Kent (County) Located in: Vergennes Township Corner Code #

1. Public Land Survey	T <u>7N</u> R <u>9W</u>	<u>M-5</u>
	T _____ R _____	_____
	T _____ R _____	_____
	T _____ R _____	_____
2. Property Controlling in Section	S _____ T _____ R _____	_____
	S _____ T _____ R _____	_____
3. Miscellaneous Property in Sec.	S _____ T _____ R _____	_____
	S _____ T _____ R _____	_____

4. Lot No. _____, Recorded Plat _____
5. Private Claims _____

STATE OF MICHIGAN
COUNTY OF KENT
RECEIVED FOR RECORD
38 OCT 23 AM 9:58
REG. OF DEEDS
Lucy Bond

10819
Register of Deeds Stamp & File Number

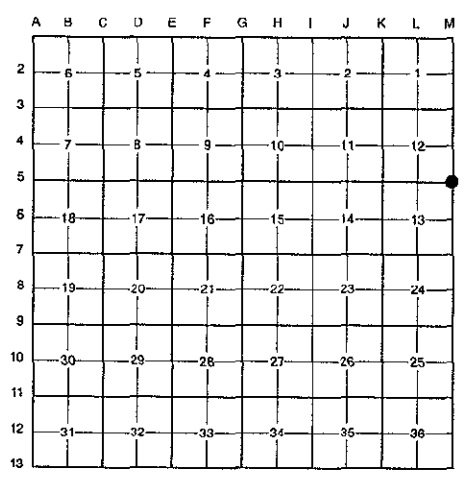

I, Randy Kolehouse, in a field survey on January 15 19 98, do hereby certify that under requirements of P.A. 74 Michigan P.A. of 1970, the corner points mentioned in lines 1 and 2 above were in conformance with regulations and rules therefore as required in the current manual of survey instructions of the United States Department of the interior, Bureau of Land Management or by a decree of a Court of Law and/or that the corner points mentioned in lines 3, 4 and 5 above were in conformance with the rules of the Michigan Board of Land Surveyors or by a Decree of a Court of Law; established, re-established, monumented, re-monumented, recovered, found as expressed below:

NOTE: Not more than 4 corners, all in the same town and range, may be recorded on this certificate.

A. Description of original monument and accessories and/or subsequent restoration:

M-5	1837	G.L.O. Notes	N. Brookfield	Set Post
	1976	L.C.R.C. L. 1 P. 202	N/A	2" Iron (Ionia County)
	1990	L.C.R.C. #5315	T. Chettleburgh	Fnd. 2" Iron Pipe / Set K.C. Monument
	1995	L.C.R.C. #8279	William Byl	K.C. Monument

P.A. 345 1990 KENT COUNTY
PEER APPROVED 2/19/98
CHAIRMAN Randy Kolehouse

Note: This corner is common with A-5, T7N, R8W.
This corner was originally approved by the Kent County Remonumentation Peer Group and monumented by T. Chettleburgh on 1/12/90 and was recorded per L.C.R.C. #5315.

B. Description of corner evidence found and/or method applied in restoring or reestablishing corner:

M-5 Found a Standard Kent County Monument 28' East of a gravel drive running North and South, on line of a fence line and tree row running North, and 6' North of a fence line and tree row running running East, per L.C.R.C.'s #5315 and #8279 as set by T. Chettleburgh in place of a 2" iron pipe he found which checked L.C.R.C. L. 1 P. 202 of Ionia County records.

L.C.R.C. #5315

L.C.R.C. #8279


- Nail & KC Remon tag in W. side of 21" Wild Cherry N00°E 19.51'
- Nail & KC Remon tag in NW side of 14" Wild Cherry N67°E 5.76'
- Nail & KC Remon tag in N. side of 19" Oak S88°E 10.77'
- NW corner of iron fence corner post S23°E 4.19'
- Nail & KC Remon tag in W. side of 12" Oak S05°E 15.21'

- Nail & KC Remon. tag W. side 24" W. Cherry N00°E 19.53' (m. 19.55')
- Nail & KC Remon. tag NW side 18" W. Cherry N67°E 5.79' (m. 5.78')
- Nail & KC Remon. tag N. side 22" Oak S88°E 10.81' (m. 10.82')
- NW corner of iron fence corner post S23°E 4.19'
- Nail & KC Remon. tag W. side 14" Oak S05°E 15.25' (m. 15.24')

The selected location is accepted by me and is generally accepted by professional surveyors as the best available evidence of the position of the original corner.

C. Description of monument for corner and accessories established to perpetuate locating the position of the corner:

- M-5 Standard Kent County Monument
- Nail & K.C. remon. tag on W side 24" W. Cherry N 00° E 19.55'
 - Nail & K.C. remon. tag on NW side 18" W. Cherry N 67° E 5.78'
 - Nail & K.C. remon. tag on N side 22" Oak S 88° E 10.82'
 - NW cor. Of iron fence cor. post S 23° E 4.19'
 - Nail & K.C. remon. tag on W side 14" Oak S 05° E 15.24'
 - C/L gravel drive running N-S, West 28.0'
 - On fence line and tree row running N
 - Fence line and tree row running E, South 6.0'

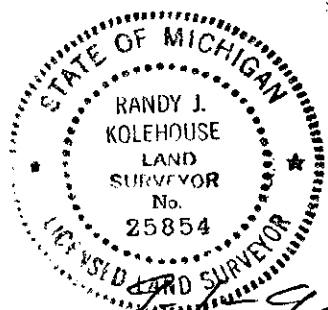

Signed by Randy J. Kolehouse
EARTH TECH

Date 1/19/98

Surveyor's Michigan License No. 25854