

SURVEY & RECONUMENTATION
 \$7.00
 \$2.00
 MAR 08 1999

LAND CORNER RECORDATION CERTIFICATE
Filing Requirement of Act 74, Mich. P.A. 1970
KENT COUNTY REMONUMENTATION

For corners in SECTION _____

Kent (County)	Located in: Vergennes Township	Corner Code #
1. Public Land Survey	T <u>7N</u> R <u>9W</u>	<u>M-6</u>
	T _____ R _____	_____
	T _____ R _____	_____
	T _____ R _____	_____
2. Property Controlling in Section	S _____ T _____ R _____	_____
	S _____ T _____ R _____	_____
3. Miscellaneous Property in Sec.	S _____ T _____ R _____	_____
	S _____ T _____ R _____	_____
4. Lot No. _____, Recorded Plat _____		
5. Private Claims _____		

STATE OF MICHIGAN
 COUNTY OF KENT
 RECEIVED FOR RECORD
 98 OCT 23 AM 9:58
 REG. OF DEEDS
Eric Stand

10820
 Register of Deeds Stamp & File Number

	A	B	C	D	E	F	G	H	I	J	K	L	M
2	6	5	4	3	2	1							
3													
4	7	8	9	10	11	12							
5													
6	18	17	16	15	14	13							
7													
8	19	20	21	22	23	24							
9													
10	30	29	28	27	26	25							
11													
12	31	32	33	34	35	36							
13													

I, Randy Kolehouse, in a field survey on January 12 19 98, do hereby certify that under requirements of P.A. 74 Michigan P.A. of 1970, the corner points mentioned in lines 1 and 2 above were in conformance with regulations and rules therefore as required in the current manual of survey instructions of the United States Department of the Interior, Bureau of Land Management or by a decree of a Court of Law and/or that the corner points mentioned in lines 3, 4 and 5 above were in conformance with the rules of the Michigan Board of Land Surveyors or by a Decree of a Court of Law; established, re-established, monumented, re-monumented, recovered, found as expressed below:

NOTE: Not more than 4 corners, all in the same town and range, may be recorded on this certificate.

A. Description of original monument and accessories and/or subsequent restoration:

M-6	1837	G.L.O. Notes	N. Brookfield	Set Post
	1976	L.C.R.C. L. 1 P. 202	Medema, Van Kooten & Assoc.	Capped Iron in 2" Iron Pipe (Ionia County)
	1990	L.C.R.C. #5316	T. Chettleburgh	Fnd. Capped Iron Bar / Set K.C. Monument
	1995	L.C.R.C. #8280	William Byl	K.C. Monument

Note: This corner is common with A-6, T7N, R8W.

This corner was originally approved by the Kent County Remonumentation Peer Group and monumented by T. Chettleburgh on 1/31/90 and was recorded per L.C.R.C. #5316.

B. Description of corner evidence found and/or method applied in restoring or reestablishing corner:

M-6 Found a Standard Kent County Monument on the C/L of Montcalm Avenue (two track) running South and the approximate C/L of Bozung Road (abandoned) running East and 12' ± West of the East right-of-way fence of Montcalm Avenue. This monument is 100' ± North of the North end of two track (Montcalm Avenue). Checks L.C.R.C.'s #5316 and #8280 as set by T. Chettleburgh in place of an iron bar he found in a 2" iron pipe which checked L.C.R.C. L. 1 P. 202 of the Ionia County records.

L.C.R.C. #5316

L.C.R.C. #8280

- Nail & KC Remon tag in NW side of 13" Oak N45°E 3.15'
- Nail & KC Remon tag in SE side of 16" Walnut N72°E 64.04'
- Nail & KC Remon tag in NE side of 14" Maple S61°E 47.59'
- Nail & KC Remon tag in SE side of 14" Walnut S 22°W 74.10'
- Nail & KC Remon tag in NW side of 30" Maple S77°W 38.46'
- Nail & KC Remon tag in SW side of 22" Oak N23°W 16.11'

- Nail & KC Remon. tag NW side 15" Oak N45°E 3.17'
- Nail & KC Remon. tag SE side 18" Walnut N72°E 64.08' (m. 64.06')
- Nail & KC Remon. tag NE side 16" Maple S61°E 47.66' (m. 47.60')
- Nail & KC Remon. tag SE side 16" Walnut S22°W 74.10' (m. 74.02')
- Nail & KC Remon. tag NW side 32" Maple S77°W 38.46' (m. 38.44')
- Nail & KC Remon. tag SW side 24" Oak N23°W 16.14' (m. 16.11')

The selected location is accepted by me and is generally accepted by professional surveyors as the best available evidence of the position of the original corner.

C. Description of monument for corner and accessories established to perpetuate locating the position of the corner:

M-6 Standard Kent County Monument


- Nail & K.C. remon. tag on NW side 15" Oak N 45° E 3.17'
- Nail & K.C. remon. tag on SE side 18" Walnut N 72° E 64.06'
- Nail & K.C. remon. tag on NE side 16" Maple S 61° E 47.60'
- Nail & K.C. remon. tag on NW side 32" Maple S 77° W 38.44'

- Nail & K.C. remon. tag on SE side 16" Walnut S 22° W 74.02'
- Nail & K.C. remon. tag on SW side 24" Oak N 23° W 16.11'
- On C/L two track running S
- On C/L abandoned road running E
- East R/W fence, East 12' ±

Signed by Randy J. Kolehouse Date 9-1-

EARTH TECH

Surveyor's Michigan License No. 25854

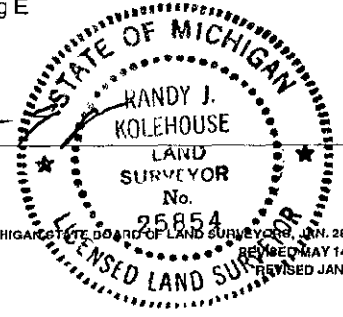

P.A. 345 1990 KENT COUNTY FORM APPROVED BY MICHIGAN BOARD OF LAND SURVEYORS, JAN. 28, 1971
 PEER APPROVED 2/19/98
 CHAIRMAN [Signature]
 REVISED MAY 14, 1975
 REVISED JAN., 1993