

\$27.00 SURVEY & REMONUMENTATION
 \$2.00
 MAR 08 1999


LAND CORNER RECORDATION CERTIFICATE
Filing Requirement of Act 74, Mich. P.A. 1970
KENT COUNTY REMONUMENTATION

STATE OF MICHIGAN
 COUNTY OF KENT
 RECEIVED FOR RECORD
 38 OCT 23 AM 9:58
 REG. OF DEEDS
Lucy J. Kolehose

For corners in SECTION	Kent (County)	Located in: Vergennes Township	Corner Code #
1. Public Land Survey		T <u>7N</u> R <u>9W</u>	<u>M-7</u>
		T _____ R _____	_____
		T _____ R _____	_____
		T _____ R _____	_____
2. Property Controlling In Section	S _____	T _____ R _____	_____
	S _____	T _____ R _____	_____
3. Miscellaneous Property in Sec.	S _____	T _____ R _____	_____
	S _____	T _____ R _____	_____

10821
 Register of Deeds Stamp & File Number

4. Lot No. _____, Recorded Plat _____
 5. Private Claims _____

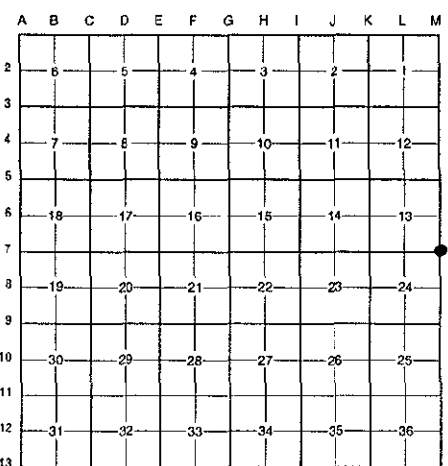

I, Randy Kolehose, in a field survey on January 9 19 98, do hereby certify that under requirements of P.A. 74 Michigan P.A. of 1970, the corner points mentioned in lines 1 and 2 above were in conformance with regulations and rules therefore as required in the current manual of survey instructions of the United States Department of the interior, Bureau of Land Management or by a decree of a Court of Law and/or that the corner points mentioned in lines 3, 4 and 5 above were in conformance with the rules of the Michigan Board of Land Surveyors or by a Decree of a Court of Law; established, re-established, monumented, re-monumented, recovered, found as expressed below:

NOTE: Not more than 4 corners, all in the same town and range, may be recorded on this certificate.

A. Description of original monument and accessories and/or subsequent restoration:

M-7	Description	Notes	Monument
1837	G.L.O. Notes	N. Brookfield	Set Post
1951	Notes	Williams & Works	Set Iron
1951-52	Witness Map	K.C. Surveyor	N/A
1976	L.C.R.C. L. 1 P. 204	Medema, Van Kooten & Assoc.	1-1/2" Iron (Ionia County)
1985	L.C.R.C. #4293	Williams & Works	Iron Bolt
1990	L.C.R.C. #5317	T. Chettleburgh	Fnd. Bolt in Iron Pipe / Set K.C. Monument
1995	L.C.R.C. #8281	William Byl	K.C. Monument

P.A. 345 1990 KENT COUNTY
 PEER APPROVED 2/19/98
 CHAIRMAN Henry Huber

Note: This corner is common with A-7, T7N, R8W.

This corner was originally approved by the Kent County Remonumentation Peer Group and monumented by T. Chettleburgh on 1/31/90 and was recorded per L.C.R.C. #5317.

B. Description of corner evidence found and/or method applied in restoring or reestablishing corner:
 M-7 Found a Standard Kent County Monument at the East edge of Montcalm Avenue per L.C.R.C.'s #5317 and #8281 as set by T. Chettleburgh in place of a bolt he found in an iron pipe which checked L.C.R.C. #4293, L.C.R.C. L. 1 P. 204 of the Ionia County records, the 1951-52 notes of Williams & Works, and the K.C. Surveyor's records.

L.C.R.C. #5317
 Nail & KC Remon tag in SE side of Power Pole N46°E 32.82'
 Nail & KC Remon tag in SE side of 25' Oak N56°E 40.54'
 Iron Bar (MVK) S84°E 33.00'
 Nail & KC Remon tag in NE side of 13" Maple S38°E 58.50'
 Nail & KC Remon tag in NW side of 13" Oak S25°W 44.35'
 Nail & KC Remon tag in NW side of tri 10" Oak S44°W 28.75'
 Nail & KC Remon tag in SW side of 27" Oak N73°W 34.10'
 Nail & KC Remon tag in NE side of 20" Oak N65°W 31.43'
 Nail & KC Remon tag in NE side of 16" Oak N26°W 43.87'

L.C.R.C. #8281
 Nail & KC Remon. tag SE side P. Pole N46°E 32.89'
 Nail & KC Remon. tag SE side 25" Oak N56°E 40.59' (m. 40.56')
 Nail & KC Remon. tag NE side 13" Maple S38°E 58.52' (m. 58.74')
 Nail & KC Remon. tag NW side 13" Oak S25°W 44.31' (m. 44.54')
 Nail & KC Remon. tag NW side Tri. 10" Oak S44°W 28.72' (m. 28.79')
 Nail & KC Remon. tag SW side 27" Oak N73°W 34.10' (m. 34.05')
 Nail & KC Remon. tag NE side 20" Oak N65°W 31.46' (m. 31.48')
 Nail & KC Remon. tag NE side 16" Oak N26°W 43.89'
 Iron Bar (MVK) S84°E 33.00 (m. 33.25')

The selected location is accepted by me and is generally accepted by professional surveyors as the best available evidence of the position of the original corner.

C. Description of monument for corner and accessories established to perpetuate locating the position of the corner:
 M-7 Standard Kent County Monument
 Nail & K.C. remon. tag on SE side P. pole N 46° 32.89'
 Nail & K.C. remon. tag on SE side 25" Oak N 56° E 40.56'
 Nail & K.C. remon. tag on NE side 13" Maple S 38° E 58.74'
 Nail & K.C. remon. tag on NW side 13" Oak S 25° W 44.54'
 Nail & K.C. remon. tag on NW side 10" Tri. Oak S 44° W 28.79'
 Nail & K.C. remon. tag on SW side 20" Oak N 23° W 34.05'
 Nail & K.C. remon. tag on NE side 20" Oak N 65° W 31.46'
 Nail & K.C. remon. tag on NE side 16" Oak N 26° W 43.89'
 Iron Bar (MVK) S 84° E 33.25'

Signed by Randy J. Kolehose Date 9-1-98
 EARTH TECH

Surveyor's Michigan License No. 25854

