

\$7.00
 \$2.00
 SURVEY &
 REMONUMENTATION
 MAR 08 1999

LAND CORNER RECORDATION CERTIFICATE
Filing Requirement of Act 74, Mich. P.A. 1970
KENT COUNTY REMONUMENTATION

STATE OF MICHIGAN
 COUNTY OF KENT
 RECEIVED FOR RECORD
 38 OCT 23 AM 9: 59
 REG. OF DEEDS
[Signature]

SECTION


Kent (County)	Located in: Vergennes Township	Corner Code #
1. Public Land Survey	T <u>7N</u> R <u>9W</u>	<u>M-8</u>
	T _____ R _____	_____
	T _____ R _____	_____
	T _____ R _____	_____
2. Property Controlling in Section	S _____ T _____ R _____	_____
	S _____ T _____ R _____	_____
3. Miscellaneous Property in Sec.	S _____ T _____ R _____	_____
	S _____ T _____ R _____	_____

10322

Register of Deeds Stamp & File Number

4. Lot No. _____, Recorded Plat _____
5. Private Claims _____

I, Randy Kolehouse, in a field survey on January 9 19 98, do hereby certify that under requirements of P.A. 74 Michigan P.A. of 1970, the corner points mentioned in lines 1 and 2 above were in conformance with regulations and rules therefore as required in the current manual of survey instructions of the United States Department of the interior, Bureau of Land Management or by a decree of a Court of Law and/or that the corner points mentioned in lines 3, 4 and 5 above were in conformance with the rules of the Michigan Board of Land Surveyors or by a Decree of a Court of Law; established, re-established, monumented, re-monumented, recovered, found as expressed below:

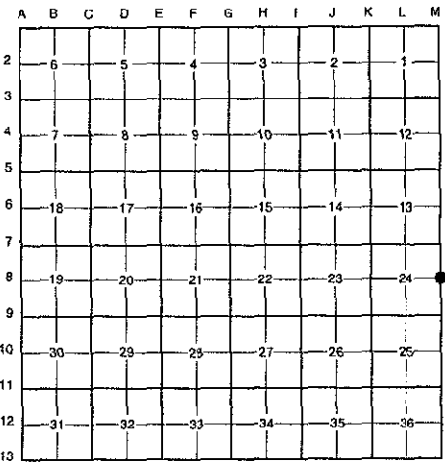

NOTE: Not more than 4 corners, all in the same town and range, may be recorded on this certificate.

A. Description of original monument and accessories and/or subsequent restoration:

M-8	1837	G.L.O. Notes	N. Brookfield	Set Post
	1937	Witness Map	K.C. Surveyor	Boat Spike
	1973	L.C.R.C. #538	Williams & Works	3/4" Iron & Steel Fence Post
	1981	L.C.R.C. #1998	Jonker Land Survey	Fnd. 3/4" Iron / Set K.C. Monument
	1995	L.C.R.C. #8282	William Byl	K.C. Monument

P.A. 345 1990 KENT COUNTY
 PEER APPROVED 2/19/98
 CHAIRMAN [Signature]

Note: This corner is common with A-8, T7N, R8W.

This corner was originally approved by the Kent County Remonumentation Peer Group and monumented by Rob Jonker on 1/4/98 and was recorded per L.C.R.C. #1998.

B. Description of corner evidence found and/or method applied in restoring or reestablishing corner:

M-8 Found a Standard Kent County Monument at the intersection of a fence line running North, East and West per L.C.R.C.'s #1998 and #8282 as set by Rob Jonker in place of a 3/4" x 26" round iron he found which checked L.C.R.C. #538 and the K.C. Surveyor's records.

L.C.R.C. #1998

L.C.R.C. #8282

- Remon. tag on E side 8" Walnut N08°W 9.53'
- Remon. tag on N side 10" W.Cherry S88°E 35.19'
- Remon. tag on E side 9" Walnut S29°E 40.75'
- Remon. tag on W side 6" Elm S12°W 33.19'
- Remon. tag on N side 6" Elm N83°W 33.37'


- Nail & KC Remon. tag E. side 12" Walnut N08°W 9.31' (m. 9.34')
- Nail & KC Remon. tag N. side 12" W. Cherry S88°E 35.11' (m. 35.12')
- Nail & KC Remon. tag E. side 12" Walnut S29°E 40.94'
- Nail & KC Remon. tag W. side 10" Elm S12°W 33.28'
- Nail & KC Remon. tag N. side 10" Elm N83°W 33.51'

The selected location is accepted by me and is generally accepted by professional surveyors as the best available evidence of the position of the original corner.

C. Description of monument for corner and accessories established to perpetuate locating the position of the corner:

M-8 Standard Kent County Monument

- Nail & K.C. remon. tag on E side 12" Walnut N 08° W 9.34'
- Nail & K.C. remon. tag on N side 12" W. Cherry S 88° E 35.12'
- Nail & K.C. remon. tag on E side 12" Walnut S 29° E 40.94'
- Nail & K.C. remon. tag on W side 10" Elm S 12° W 33.28'
- Nail & K.C. remon. tag on N side 10" Elm N 83° W 33.51'
- At "X" of fence lines running N-E-W

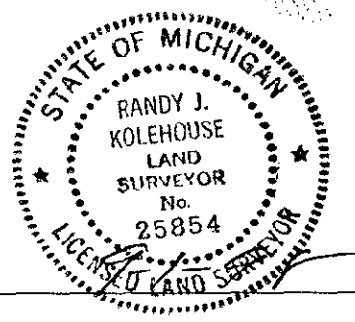

Signed by Randy J. Kolehouse Date _____

EARTHTECH

Surveyor's Michigan License No. 25854