

\$7.00  
\$2.00

SURVEY &  
REMONUMENTATION

MAR 08 1999

LAND CORNER RECORDATION CERTIFICATE  
Filing Requirement of Act 74, Mich. P.A. 1970  
KENT COUNTY REMONUMENTATION

For corners in

Kent

(County)

SECTION

Located in: Vergennes  
Township

Corner Code #

1. Public Land Survey T 7N R 9W M-11  
T \_\_\_\_\_ R \_\_\_\_\_  
T \_\_\_\_\_ R \_\_\_\_\_  
T \_\_\_\_\_ R \_\_\_\_\_
2. Property Controlling in Section S \_\_\_\_\_ T \_\_\_\_\_ R \_\_\_\_\_  
S \_\_\_\_\_ T \_\_\_\_\_ R \_\_\_\_\_
3. Miscellaneous Property in Sec. S \_\_\_\_\_ T \_\_\_\_\_ R \_\_\_\_\_  
S \_\_\_\_\_ T \_\_\_\_\_ R \_\_\_\_\_
4. Lot No. \_\_\_\_\_, Recorded Plat \_\_\_\_\_
5. Private Claims \_\_\_\_\_

REG. OF DEEDS

*Eric S. Bond*

38 DEC 14 AM 8:00

STATE OF MICHIGAN  
COUNTY OF KENT  
RECEIVED FOR RECORD

10951

Register of Deeds Stamp & File Number

I, Randy Kolehouse, in a field survey on January 8 19 98, do hereby certify that under requirements of P.A. 74 Michigan P.A. of 1970, the corner points mentioned in lines 1 and 2 above were in conformance with regulations and rules therefore as required in the current manual of survey instructions of the United States Department of the interior, Bureau of Land Management or by a decree of a Court of Law and/or that the corner points mentioned in lines 3, 4 and 5 above were in conformance with the rules of the Michigan Board of Land Surveyors or by a Decree of a Court of Law; established, re-established, monumented, re-monumented, recovered, found as expressed below:

NOTE: Not more than 4 corners, all in the same town and range, may be recorded on this certificate.

A. Description of original monument and accessories and/or subsequent restoration:

M-11	1837	G.L.O. Notes	N. Brookfield	Set Post
	1977	L.C.R.C. #1062	Hay	Iron and Cap
	1981	L.C.R.C. #2001	Jonker Land Survey	Fnd. Iron and Cap / Set K.C. Monument
	1995	L.C.R.C. #8285	William Byl	K.C. Monument

PEER APPROVED 2/19/98  
CHAIRMAN *Harry Huber*

Note: This corner is not common with A-11, T7N, R8W.

This corner was originally approved by the Kent County Remonumentation Peer Group and monumented by Rob Jonker on 8/11/81 and was recorded per L.C.R.C. #2001.

B. Description of corner evidence found and/or method applied in restoring or reestablishing corner:

M-11 Found a Standard Kent County Monument at the C/L of Montcalm Avenue (gravel) running North and South .4' below grade and North 96' ± of the C/L of a gravel trail running East per L.C.R.C.'s #2001 and #8285 as set by Rob Jonker in place of an iron and cap he found which checked L.C.R.C. #1062.

L.C.R.C. #2001

L.C.R.C. #8285

Remon. tag on SE side 36" Oak S37°W 47.12'  
Remon. tag on SW side 28" Oak N28°W 46.14'  
Remon. tag on W side 12" W.Cherry N43°E 35.22'  
Remon. tag on N side 12" Poplar S45°E 43.64'  
Iron & cap N88°W m/l 32.84'


Nail & KC Remon. tag SE side 52" Oak S37°W 47.11'  
Nail & KC Remon. tag SW side 40" Oak N28°W 46.28' (m. 46.03')  
Nail & KC Remon. tag W. side, 18" W. Cherry N43°E 35.28' (m. 35.21')  
Nail & KC Remon. tag N. side 16" Poplar S45°E 43.66' (m. 43.64')  
Iron & cap N88°W 32.84'

The selected location is accepted by me and is generally accepted by professional surveyors as the best available evidence of the position of the original corner.

C. Description of monument for corner and accessories established to perpetuate locating the position of the corner:

M-11 Standard Kent County Monument

Nail & K.C. remon. tag on SE side 52" Oak S 37° W 47.11'  
Nail & K.C. remon. tag on SW side 40" Oak N 28° W 46.03'  
Nail & K.C. remon. tag on W side 18" W. Cherry N 43° E 35.21'  
Nail & K.C. remon. tag on N side 16" Poplar S 45° E 43.64'  
Copper iron N 88° W 32.84'  
On C/L of gravel road running N-S  
C/L of gravel trail running E, South 96' ±

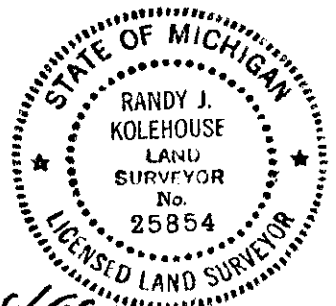

Signed by *Randy J. Kolehouse* Date 11/18/98

EARTH TECH

Surveyor's Michigan License No. 25854