

\$7.00
\$2.00

MAR 08 1999

LAND CORNER RECORDATION CERTIFICATE
Filing Requirement of Act 74, Mich. P.A. 1970
KENT COUNTY REMONUMENTATION

For corners in SECTION

Kent (County)	Located in: Vergennes Township	Corner Code #
1. Public Land Survey	T <u>7N</u> R <u>9W</u>	<u>M-12</u>
	T _____ R _____	_____
	T _____ R _____	_____
	T _____ R _____	_____
2. Property Controlling in Section	S _____ T _____ R _____	_____
	S _____ T _____ R _____	_____
3. Miscellaneous Property in Sec.	S _____ T _____ R _____	_____
	S _____ T _____ R _____	_____

STATE OF MICHIGAN
COUNTY OF KENT
RECEIVED FOR RECORD
98 DEC 14 AM 8:00
REG. OF DEEDS
[Signature]

10952

Register of Deeds Stamp & File Number

- 4. Lot No. _____, Recorded Plat _____
- 5. Private Claims _____

I, Randy Kolehouse, in a field survey on January 8 19 98, do hereby certify that under requirements of P.A. 74 Michigan P.A. of 1970, the corner points mentioned in lines 1 and 2 above were in conformance with regulations and rules therefore as required in the current manual of survey instructions of the United States Department of the interior, Bureau of Land Management or by a decree of a Court of Law and/or that the corner points mentioned in lines 3, 4 and 5 above were in conformance with the rules of the Michigan Board of Land Surveyors or by a Decree of a Court of Law; established, re-established, monumented, re-monumented, recovered, found as expressed below:

NOTE: Not more than 4 corners, all in the same town and range, may be recorded on this certificate.

A. Description of original monument and accessories and/or subsequent restoration:

M-12	1837	G.L.O. Notes	N. Brookfield	Set Post
	1990	L.C.R.C. #5318	T. Chettleburgh	Set K.C. Monument

A	B	C	D	E	F	G	H	I	J	K	L	M
2	6	5	4	3	2	1						
3												
4	7	8	9	10	11	12						
5												
6	18	17	16	15	14	13						
7												
8	19	20	21	22	23	24						
9												
10	30	29	28	27	26	25						
11												
12	31	32	33	34	35	36						
13												

P.A. 345 1990 KENT COUNTY
PEER APPROVED 2/19/98
CHAIRMAN [Signature]

Note: This corner is not common with A-12, T7N, R8W.

This corner was originally approved by the Kent County Remonumentation Peer Group and monumented by T. Chettleburgh on 2/17/90 and was recorded per L.C.R.C. #5318.

B. Description of corner evidence found and/or method applied in restoring or reestablishing corner:

M-12 Found a Standard Kent County Monument (.6' below grade) 2.0' West of the C/L of Montcaim Avenue (gravel) running North and South and 6.0' North of the C/L of Grindle Drive (gravel) running West per L.C.R.C.'s #5318 as set by T. Chettleburgh at mid-point and on line with Ionia County closing corner A-12.


L.C.R.C. #5318

- Nail & KC Remon tag in SE side of 14" Oak N79°E 18.19' (m. 18.21')
- Nail & KC Remon tag in S. side of 21" Oak S89°E 40.87' (m. 40.90')
- Nail & KC Remon tag in W. side of 23" Oak S03°E 102.51' (m. 102.59')
- Nail & KC Remon tag in SE side of Power Pole S18°W 120.10' (m. 120.19')
- Nail & KC Remon tag in NE side of Power Pole N18°W 80.25'

The selected location is accepted by me and is generally accepted by professional surveyors as the best available evidence of the position of the original corner.

C. Description of monument for corner and accessories established to perpetuate locating the position of the corner:

- M-12 Standard Kent County Monument
- Nail & K.C. remon. tag on SE side 14" Oak N 79° E 18.21'
- Nail & K.C. remon. tag on S side 22" Oak S 89° E 40.90'
- Nail & K.C. remon. tag on W side 24" Oak S 03° E 102.59'
- Nail & K.C. remon. tag on SE side P. pole S 18° W 120.19'
- Nail & K.C. remon. tag on NE side P. pole N 18° W 80.25'
- C/L of gravel road running N-S, East 2.0'
- C/L of gravel road running W, South 6.0'

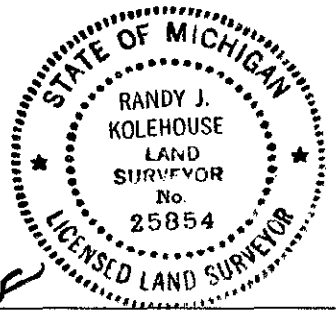

Signed by Randy J. Kolehouse
EARTH TECH

Date 11/18/98

Surveyor's Michigan License No. 25854