

**SURVEY & REMONUMENTATION**

APR 28 1995

KENT COUNTY REMONUMENTATION

STATE OF MICHIGAN  
COUNTY OF KENT  
RECEIVED FOR RECORD  
94 DEC -5 AM 9:00

COMMISSION

LAND CORNER RECORDATION CERTIFICATE  
Filing Requirement of Act 74, Mich. P.A. 1970

For corners in  
KENT COUNTY

(County)	Located In:	Corner Code #
1. Public Land Survey	T 6N R 11W	M-1
	T 6N R 10W	A-1
	T 7N R 11W	M-13
	T 7N R 10W	A-13
2. Property Controlling in Section	S T R	
	S T R	
3. Miscellaneous Property in Sec.	S T R	
	S T R	

*Lucy J. Bond*  
REG. OF DEEDS

7710

Register of Deeds Stamp & File Number

4. Lot No. \_\_\_\_\_, Recorded Plat \_\_\_\_\_  
5. Private Claims \_\_\_\_\_

	A	B	C	D	E	F	G	H	I	J	K	L	M
2	6		5		4		3		2				
3													
4	7		8		9		10		11		12		
5													
6	18		17		16		15		14		13		
7													
8	19		20		21		22		23		24		
9													
10	30		29		28		27		26		25		
11													
12	31		32		33		34		35		36		
13													

I, William R. Byl, in a field survey on July 7, 19 94, do hereby certify that under requirements of P.A. 74, Michigan P.A. of 1970, the corner points mentioned in lines 1 and 2 above were in conformance with regulations and rules therefore as required in the current manual of survey instructions of the United States Department of the Interior, Bureau of Land Management or by a decree of a Court of Law and/or that the corner points mentioned in lines 3, 4 and 5 above were in conformance with the rules of the Michigan Board of Land Surveyors or by a Decree of a Court of Law; established, re-established, monumented, re-monumented, recovered, found as expressed below:

NOTE: Not more than 4 corners, all in the same town and range, may be recorded on this certificate.

A. Description of original monument and accessories and/or subsequent restoration:

M-1	1831	GLO	Mullett	Set Post
	1966	Kent Co. Wit.		5/8" Solid Iron
	1984	LCRC #3862	Rosema	Set Kent County Monument
	1991	LCRC #6419	Marschall	Kent County Monument

P.A. 345 1990 KENT COUNTY  
PEER APPROVED 12/1/94  
CHAIRMAN *Stanley Huber*

The position of this corner was previously approved by the Kent County Remonumentation Peer Group, monumented by Maurice J. Rosema on 7/11/84 and was recorded per LCRC #3862.

B. Description of corner evidence found and/or method applied in restoring or reestablishing corner:

M-1 Found standard Kent Co. Mon. (Harrison) per witnesses from above LCRC as set by Maurice J. Rosema in place of the 1/2" Iron he found. Said Iron checks with plats to SW and NW of corner. All Kent Co. Wit. gone.


LCRC #3862		LCRC #6419	
Nail & tag 6" Hickory	N14°E 59.59'	Nail & tag N. side 10" Apple	N43°W 47.26'
SE cor. brick chimney	N68°W 108.00'	Nail & tag E. side 6" Oak	N15°E 59.54'
Nail & tag 18" Hickory	S02°E 172.77'	Nail & tag SE side 10" Elm	N27°E 75.86'
NE cor. garage (brick)	S48°W 99.33'	Top centerline hydrant	N50°E 67.25'
Nail & tag 20" Oak	N78°E 147.90'	Nail & tag SW side P. Pole	S46°E 70.18'
On C/L E-W B.T. road			
C/L B.T. road to N. is W. 4'			

The selected location is accepted by me and is generally accepted by professional surveyors as the best available evidence of the position of the original corner.

C. Description of monument for corner and accessories established to perpetuate locating the position of the corner:

M-1 Standard Kent County Monument

Nail & KC Remon. tag N. side 10" Apple	N43°W 47.34'
Nail & KC Remon. tag SE side 10" Elm	N27°E 76.05'
Top centerline hydrant	N50°E 67.29'
Nail & KC Remon. tag SW side P. Pole (moved)	S45°E 83.14'
On C/L E-W B.T. road	
C/L B.T. road to N. is W. 4'	

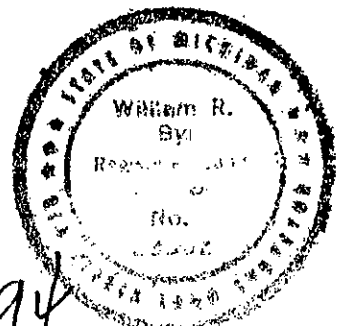

igned by *W. R. Byl*  
urveyor's Michigan License No. 23502

Date 12/1/94