

SURVEY & REMONUMENTATION

MAR 03 1998

\$7.00
\$2.00

STATE OF MICHIGAN
COUNTY OF KENT
RECEIVED FOR RECORD

SECTION

LAND CORNER RECORDATION CERTIFICATE 97 DEC 15 AM 10:41
Filing Requirement of Act 74, Mich. P.A. 1970
KENT COUNTY REMONUMENTATION

W. J. Kolehouse
REG. OF DEEDS

For corners in


Kent (County)	Located in:	Ada Township	Corner Code #
1. Public Land Survey	T <u>7N</u>	R <u>10W</u>	<u>B-1</u>
	T _____	R _____	_____
	T _____	R _____	_____
	T _____	R _____	_____
2. Property Controlling in Section	S _____	T _____	R _____
	S _____	T _____	R _____
3. Miscellaneous Property in Sec.	S _____	T _____	R _____
	S _____	T _____	R _____

10348

Register of Deeds Stamp & File Number

4. Lot No. _____, Recorded Plat _____
5. Private Claims _____

I, Randy Kolehouse, in a field survey on November 14 19 97, do hereby certify that under requirements of P.A. 74 Michigan P.A. of 1970, the corner points mentioned in lines 1 and 2 above were in conformance with regulations and rules therefore as required in the current manual of survey instructions of the United States Department of the Interior, Bureau of Land Management or by a decree of a Court of Law and/or that the corner points mentioned in lines 3, 4 and 5 above were in conformance with the rules of the Michigan Board of Land Surveyors or by a Decree of a Court of Law; established, re-established, monumented, re-monumented, recovered, found as expressed below:

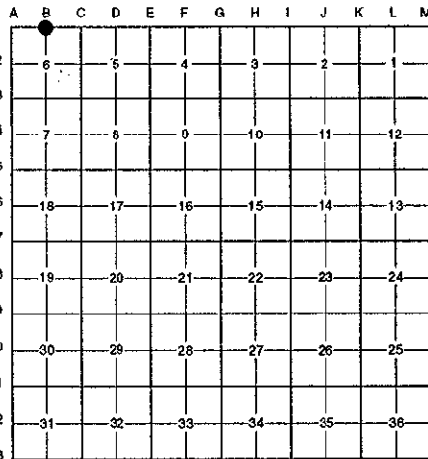

NOTE: Not more than 4 corners, all in the same town and range, may be recorded on this certificate.

A. Description of original monument and accessories and/or subsequent restoration:

B-1 This corner was not originally set by the G.L.O.

- | | | | |
|------|----------------|-----------------|---|
| 1991 | L.C.R.C. #5763 | T. Chettleburgh | Set K.C. Monument on W'ly Extension of S. Line of Section 31, T8N, R10W |
| 1991 | L.C.R.C. #6265 | Chris Marschall | K.C. Monument |

P.A. 345 1990 KENT COUNTY

PEER APPROVED 11/20/97

CHAIRMAN *W. J. Kolehouse*

Note: This corner is not common with B-13, T8N, R10W.

This corner was originally approved by the Kent County Remonumentation Peer Group and monumented by T. Chettleburgh on 2/6/91 and was recorded per L.C.R.C. #5763.

B. Description of corner evidence found and/or method applied in restoring or reestablishing corner:

B-1 Found a Standard Kent County Monument in a swamp 303.4' ± West of B-13, T8N, R10W per L.C.R.C.'s #5763 and #6265 as set by T. Chettleburgh.

L.C.R.C. #5763

L.C.R.C. #6265


- | | |
|--|---|
| KC Remon tag in W. side of 16" Ash N 20° E 44.68' | Nail & Tag NE sd. 18" Maple S 22° E 25.16' (m. 25.2') |
| KC Remon tag in NW side of 17" Maple N 67° E 24.00' | Nail & Tag S sd. 19" Ash N 80° W 47.61' broken over (m. 47.6') |
| KC Remon tag in NE side of 16" Maple S 22° E 25.17' | Nail & Tag W sd. 18" Ash N 20° E 44.67' (m. 44.7') |
| KC Remon tag in S. side of 19" Ash N 80° W 47.60' | Nail & Tag NW sd. 18" Maple N 67° E 24.00' |
| KC Remon tag in NE side of 21" Ash N 27° W 44.71' | Nail & Tag NE sd. 24" Ash N 27° W 44.70' |
| B-13, T8N, R10W (Kent County Monument) N 90° E 303.42' | Nail & Tag SE sd. 26" Ash (leaning to West) S 60° W 8.62' (m. 8.6') |

The selected location is accepted by me and is generally accepted by professional surveyors as the best available evidence of the position of the original corner.

C. Description of monument for corner and accessories established to perpetuate locating the position of the corner:

B-1 Standard Kent County Monument

- Nail & K.C. remon. tag on NE side 18" Maple S 20° E 25.2'
- Nail & K.C. remon. tag on S side 20" Ash N 81° W 47.6' (broken over)
- Nail & K.C. remon. tag on W side 18" Ash N 20° E 44.7'
- Nail & K.C. remon. tag on NW side 18" Maple N 66° E 24.0'
- Nail & K.C. remon. tag on NE side 24" Ash N 28° W 44.7'
- Nail & K.C. remon. tag on SE side 24" Maple (leaning) S 60° W 8.6'
- K.C. Mon., B-13, T8N, R10W, East 303.42'

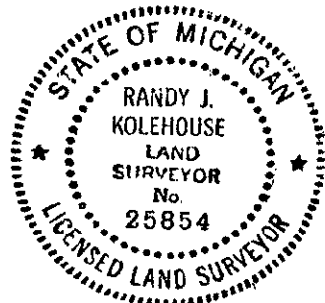

Signed by *Randy J. Kolehouse*

Date 11/28/97

EARTH TECH

Surveyor's Michigan License No. 25854