

SURVEY & REMONUMENTATION

MAR 03 1998

\$7.00
\$2.00

SECTION

LAND CORNER RECORDATION CERTIFICATE
Filing Requirement of Act 74, Mich. P.A. 1970
KENT COUNTY REMONUMENTATION

For corners in


Kent (County)	Located in: Township	Ada	Corner Code #
1. Public Land Survey	T <u>7N</u> R <u>10W</u>		<u>B-3</u>
	T _____ R _____		_____
	T _____ R _____		_____
	T _____ R _____		_____
2. Property Controlling in Section	S _____ T _____ R _____		_____
	S _____ T _____ R _____		_____
3. Miscellaneous Property in Sec.	S _____ T _____ R _____		_____
	S _____ T _____ R _____		_____

STATE OF MICHIGAN
COUNTY OF KENT
RECEIVED FOR RECORD
97 NOV 14 AM 9:00
REG. OF DEEDS
David D. Dand

10308

Register of Deeds Stamp & File Number

- 4. Lot No. _____, Recorded Plat _____
- 5. Private Claims _____

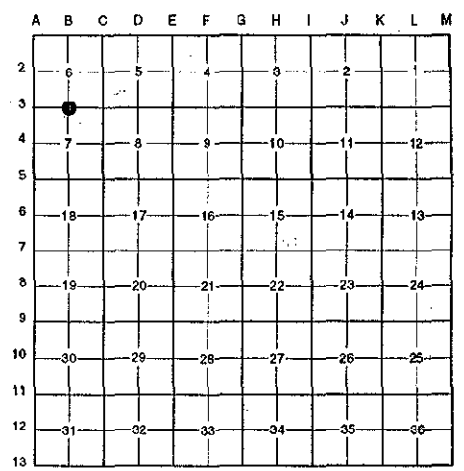

I, Randy Kolehouse, in a field survey on August 8 19 97, do hereby certify that under requirements of P.A. 74 Michigan P.A. of 1970, the corner points mentioned in lines 1 and 2 above were in conformance with regulations and rules therefore as required in the current manual of survey instructions of the United States Department of the interior, Bureau of Land Management or by a decree of a Court of Law and/or that the corner points mentioned in lines 3, 4 and 5 above were in conformance with the rules of the Michigan Board of Land Surveyors or by a Decree of a Court of Law; established, re-established, monumented, re-monumented, recovered, found as expressed below:

NOTE: Not more than 4 corners, all in the same town and range, may be recorded on this certificate.

A. Description of original monument and accessories and/or subsequent restoration:

B-3	1831	G.L.O. Notes	Mullett	Set Post
	1974	L.C.R.C. #1013	Medema, Van Kooten & Assoc.	N/A
	1981	L.C.R.C. #2544	J. Bueche	Fnd. 1/2" x 13" Rerod / Set K.C. Monument
	1986	L.C.R.C. #4429	Williams & Works	Reset K.C. Monument per Medema Witnesses
	1989	L.C.R.C. #5103	T. Chettleburgh	K.C. Monument

This corner was reapproved by the Kent County Remonumentation Peer Group and monumented by Williams & Works on 4/26/86 and was recorded per L.C.R.C. #4429.

B. Description of corner evidence found and/or method applied in restoring or reestablishing corner:

B-3 Found a Standard Kent County Monument 14" ± below ground 25' ± East of edge of woods North and South, 700' ± North of tree line running East and West, and 670' ± West of the river per L.C.R.C.'s #4429 and #5103 as set by Williams & Works from witnesses provided by MVK.

L.C.R.C. #4429

L.C.R.C. #5103


Nail & K.C. Remon. tag in NE side 12" Ash N 40° W 50.22'
Nail & K.C. Remon. tag in S. side 11" Maple West 26.45'
Nail & K.C. Remon. tag in SE side Tri. 8" Maple S 45° W 30.27'
Nail & K.C. Remon. tag in W side Twin 8" Ash S 30° W 38.34'
Steel fence post West 20.7'
K.C. Monument at Meander Corner East 640.82'

K. C. Harrison Monument at Meander Corner East 640.82'
East-West tree line (South edge corn field) South 696'
K. C. Remon. Tag & Nail West side Twin 7" Ash S 48° W 38.29' (m. 38.44')
K. C. Remon. Tag & Nail Southeast side Tri 8" Maple S 64° W 30.26' (m. 30.46')
North-South tree line (West edge corn field) West 27' (m. 24')
Steel fence post top 12" above ground N 86° W 20.51' (m. 20.97')
K. C. Remon. Tag & Nail South side 10" Maple N 83° W 26.45' (m. 26.67')
K. C. Remon. Tag & Nail Northeast side 12" Ash N 24° W 50.25' (m. 50.18')

The selected location is accepted by me and is generally accepted by professional surveyors as the best available evidence of the position of the original corner.

C. Description of monument for corner and accessories established to perpetuate locating the position of the corner:

B-3 Standard Kent County Monument
Nail & K.C. remon. tag on W side Twin 10" Ash S 48° W 38.44'
Nail & K.C. remon. tag on SE side Tri. 10" Maple S 64° W 30.46'
Nail & K.C. remon. tag on S side 12" Maple N 83° W 26.67'
Nail & K.C. remon. tag on NE side 14" Ash N 24° W 50.18'
Steel fence post 10" above ground N 86° W 26.67'

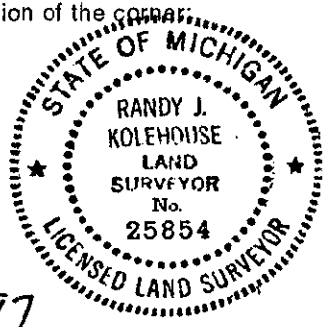

Signed by Randy J. Kolehouse Date 9/23/97
EARTH TECH

Surveyor's Michigan License No. 25854

P.A. 345 1990 KENT COUNTY
FORM APPROVED BY MICHIGAN STATE BOARD OF LAND SURVEYORS, JAN. 28, 1971
PEER APPROVED 8/28/97
CHAIRMAN Harry Hakes
REVISED MAY 14, 1975
REVISED JAN., 1983