

SURVEY & REMONUMENTATION

MAR 03 1998

SECTION

LAND CORNER RECORDATION CERTIFICATE
Filing Requirement of Act 74, Mich. P.A. 1970
KENT COUNTY REMONUMENTATION

For corners in

Kent (County)	Located in:	Ada Township	Corner Code #
1. Public Land Survey	T <u>7N</u>	R <u>10W</u>	<u>B-9</u>
	T _____	R _____	_____
	T _____	R _____	_____
	T _____	R _____	_____
2. Property Controlling in Section	S _____	T _____	R _____
	S _____	T _____	R _____
3. Miscellaneous Property in Sec.	S _____	T _____	R _____
	S _____	T _____	R _____

STATE OF MICHIGAN
 COUNTY OF KENT
 RECEIVED FOR RECORD
 97 OCT 15 AM 8:49
 REG. OF DEEDS
David J. ...

10168

Register of Deeds Stamp & File Number

4. Lot No. _____, Recorded Plat _____
 5. Private Claims _____

I, Randy Kolehouse, in a field survey on January 23 19 97, do hereby certify that under requirements of P.A. 74 Michigan P.A. of 1970, the corner points mentioned in lines 1 and 2 above were in conformance with regulations and rules therefore as required in the current manual of survey instructions of the United States Department of the interior, Bureau of Land Management or by a decree of a Court of Law and/or that the corner points mentioned in lines 3, 4 and 5 above were in conformance with the rules of the Michigan Board of Land Surveyors or by a Decree of a Court of Law; established, re-established, monumented, re-monumented, recovered, found as expressed below:

	A	B	C	D	E	F	G	H	I	J	K	L	M
2	6	5	4	3	2	1							
3													
4	7	8	9	10	11	12							
5													
6	18	17	16	15	14	13							
7													
8	19	20	21	22	23	24							
9													
10	30	29	28	27	26	25							
11													
12	31	32	33	34	35	36							
13													

NOTE: Not more than 4 corners, all in the same town and range, may be recorded on this certificate.

A. Description of original monument and accessories and/or subsequent restoration:

B-9	1831	G.L.O. Notes	Mullett	Set Post
	1944	Witness Map	K.C. Surveyor	Iron in Fence Corner
	1972	L.C.R.C. #327	Williams & Works	Iron in Fence Corner
	1977	L.C.R.C. #1071	Exxel Engineering	3/4" Iron
	1982	L.C.R.C. #3147	Moore & Bruggink	Fnd. 3/4" Iron / Set K.C. Monument
	1989	L.C.R.C. #5106	T. Chettleburgh	K.C. Monument

P.A. 345 1990 KENT COUNTY
 PEER APPROVED 5/22/97
 CHAIRMAN *[Signature]*

This corner was originally approved by the Kent County Remonumentation Peer Group and monumented by Moore & Bruggink on 8/2/82 and was recorded per L.C.R.C. #3147.

B. Description of corner evidence found and/or method applied in restoring or reestablishing corner:

B-9 Found a Standard Kent County Monument in a swamp 600' ± NNW of the C/L of a cul-de-sac in Rolling Brook Drive per L.C.R.C.'s #3147 and #5106 as set by Moore & Bruggink in place of a 3/4" iron they found which checked L.C.R.C.'s #1071, #327 and the K.C. Surveyor's records.

L.C.R.C. #3147

L.C.R.C. #5106


K.C. Nail & Tag 14" Ash N 30° E 19.37'	K.C. Remon. Tag & Nail Northwest side 15" Ash N a42° E 19.35'
K.C. Nail & Tag 18" Oak N 05° E 40.99'	K.C. Remon. Tag & Nail Southwest side 21" Oak S 50° E 87.63'
K.C. Nail & Tag 12" Dbl Maple N 05° E 25.52'	K.C. Remon. Tag & Nail South side 19" Oak N 90° W 39.83' (m. 40.05')
K.C. Nail & Tag 15" Oak N 40° W 56.14'	K.C. Remon. Tag & Nail Southwest side 15" Oak N 41° W 56.11' (m. 56.30')
K.C. Nail & Tag 20" Oak West 39.9'	K.C. Remon. Tag & Nail West side Tw. 14" Maple N 09° W 25.55'

The selected location is accepted by me and is generally accepted by professional surveyors as the best available evidence of the position of the original corner.

C. Description of monument for corner and accessories established to perpetuate locating the position of the corner:

B-9 Standard Kent County Monument

- Nail & K.C. remon. tag on NW side 15" Ash N 42° E 19.35'
- Nail & K.C. remon. tag on SW side 21" Oak S 50° E 87.63'
- Nail & K.C. remon. tag on S side 19" Oak N 90° W 40.05'
- Nail & K.C. remon. tag on SW side 15" Oak N 41° W 56.30'
- Nail & K.C. remon. tag on W side Twin 16" Maple N 09° W 25.55'

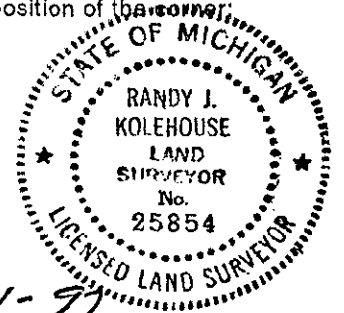

Signed by Randy J. Kolehouse Date 8-1-97
 EARTH TECH

Surveyor's Michigan License No. 25854