

**SURVEY & REMONUMENTATION**

MAR 03 1998

**LAND CORNER RECORDATION CERTIFICATE**  
**Filing Requirement of Act 74, Mich. P.A. 1970**  
**KENT COUNTY REMONUMENTATION**

STATE OF MICHIGAN  
 COUNTY OF KENT  
 RECEIVED FOR RECORD  
 97 OCT 15 AM 8:49  
 REG. OF DEEDS  
*Luci Bond*

**SECTION**

For corners in

Kent  
 (County)


Located in: Ada Corner Code #  
 Township

- |                                    |             |              |             |
|------------------------------------|-------------|--------------|-------------|
| 1. Public Land Survey              | T <u>7N</u> | R <u>10W</u> | <u>B-11</u> |
|                                    | T           | R            |             |
|                                    | T           | R            |             |
|                                    | T           | R            |             |
| 2. Property Controlling in Section | S           | T            | R           |
|                                    | S           | T            | R           |
| 3. Miscellaneous Property in Sec.  | S           | T            | R           |
|                                    | S           | T            | R           |
4. Lot No. \_\_\_\_\_, Recorded Plat \_\_\_\_\_  
 5. Private Claims \_\_\_\_\_

**10169**

Register of Deeds Stamp & File Number

I, Randy Kolehouse, in a field survey on January 22 19 97, do hereby certify that under requirements of P.A. 74 Michigan P.A. of 1970, the corner points mentioned in lines 1 and 2 above were in conformance with regulations and rules therefore as required in the current manual of survey instructions of the United States Department of the Interior, Bureau of Land Management or by a decree of a Court of Law and/or that the corner points mentioned in lines 3, 4 and 5 above were in conformance with the rules of the Michigan Board of Land Surveyors or by a Decree of a Court of Law; established, re-established, monumented, re-monumented, recovered, found as expressed below:

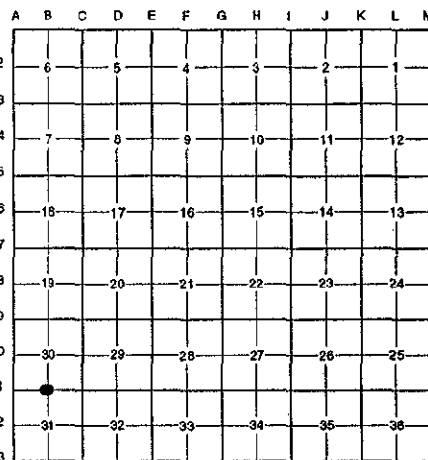

**NOTE: Not more than 4 corners, all in the same town and range, may be recorded on this certificate.**

**A. Description of original monument and accessories and/or subsequent restoration:**

B-11	1831	G.L.O. Notes	Mullett	Set Post
	1956	Witness Map	K.C. Surveyor	1/2" Iron
	1973	L.C.R.C. #544	F. Spicer	"T" Iron
	1981	L.C.R.C. #2545	J. Bueche	Fnd. "T" Iron / Set K.C. Monument
	1989	L.C.R.C. #5107	T. Chettleburgh	K.C. Monument

P.A. 345 1990 KENT COUNTY,

PEER APPROVED 8/11/97  
 CHAIRMAN Randy Kolehouse

This corner was originally approved by the Kent County Remonumentation Peer Group and monumented by J. Bueche on 12/9/81 and was recorded per L.C.R.C. #2545.

**B. Description of corner evidence found and/or method applied in restoring or reestablishing corner:**

B-11 Found a Standard Kent County Monument in a monument box 2' West of the C/L of Spaulding Avenue (bit.) running North and South on line of a tree row running East and a fence line running West per L.C.R.C.'s #2545 and #5107 as set by J. Bueche in place of a "T" iron he found which checked L.C.R.C. #544 and the K.C. Surveyor's records.

L.C.R.C. #2545

L.C.R.C. #5107

K.C. Remon. tag & nail in South side Power pole N 50° E 33.93'  
 K.C. Remon. tag & nail in East side 12" Oak S 35° W 70.30'  
 S'ly face of yard light N 20° E 78.05'  
 C/L blktp. N & S is East 2' M/L


South face of yard light post N 23° E 77.95'  
 K.C. Remon. Tag & Nail South side Power Pole N 55° E 33.93' (m. 34.08')  
 Centerline North-South Bituminous Road East 2'±  
 K.C. Remon. Tag & Nail East side 15" Oak S 35° W 70.10' (m. 70.30')

The selected location is accepted by me and is generally accepted by professional surveyors as the best available evidence of the position of the original corner.

**C. Description of monument for corner and accessories established to perpetuate locating the position of the corner:**

B-11 Standard Kent County Monument in a Monument Box

- South side yard light post N 23° E 77.95'
- Nail & K.C. remon. tag on NW side P. pole N 55° E 34.08'
- Nail & K.C. remon. tag on S side T. pole S 86° E 32.54'
- Nail & K.C. remon. tag on E side 16" Oak S 35° W 70.30'
- Top center line hyd. N 20° W 69.79'

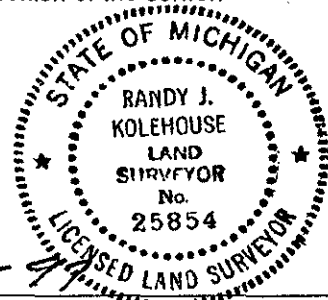

Signed by Randy J. Kolehouse  
 EARTH TECH

Date 8-1-97

Surveyor's Michigan License No. 25854