

SURVEY & REMONUMENTATION

APR 28 1995

COMMISSION

LAND CORNER RECORDATION CERTIFICATE
Filing Requirement of Act 74, Mich. P.A. 1970

STATE OF MICHIGAN
 COUNTY OF KENT
 RECEIVED FOR RECORD
 94 DEC 28 PM 3:04

For corners in

<u>Kent</u> (County) <u>Ada Township</u>	Located In:	Corner Code #
1. Public Land Survey	T <u>7N</u> R <u>10W</u>	<u>B-12</u> <u>Center</u> <u>Section 31</u>
	T _____ R _____	_____
	T _____ R _____	_____
	T _____ R _____	_____
2. Property Controlling in Section	S _____ T _____ R _____	_____
	S _____ T _____ R _____	_____
3. Miscellaneous Property in Sec.	S _____ T _____ R _____	_____
	S _____ T _____ R _____	_____

Lucy Bond
 REG. OF DEEDS

7928

Register of Deeds Stamp & File Number

4. Lot No. _____, Recorded Plat _____
 5. Private Claims _____

I, Thomas W. Chettleburgh, in a field survey on December 14, 1994, do hereby certify that under requirements of P.A. 74, Michigan P.A. of 1970, the corner points mentioned in lines 1 and 2 above were in conformance with regulations and rules therefore as required in the current manual of survey instructions of the United States Department of the Interior, Bureau of Land Management or by a decree of a Court of Law and/or that the corner points mentioned in lines 3, 4 and 5 above were in conformance with the rules of the Michigan Board of Land Surveyors or by a Decree of a Court of Law; established, re-established, monumented, re-monumented, recovered, found as expressed below:

A	B	C	D	E	F	G	H	I	J	K	L	M
2	6	5	4	3	2	1						
3												
4	7	8	9	10	11	12						
5												
6	18	17	16	15	14	13						
7												
8	19	20	21	22	23	24						
9												
10	30	29	28	27	26	25						
11												
12	●	32	33	34	35	36						
13												

NOTE: Not more than 4 corners, all in the same town and range, may be recorded on this certificate.

A. Description of original monument and accessories and/or subsequent restoration:

- Corner Post not set by U.S. Government Land Surveys
- Williams & Works 1917 Established corner
- Williams & Works 1933 Reset corner as established above
- Williams & Works 1969 Set "T" iron at corner as established above
- Williams & Works 1973 Held "T" iron, Recorded L.C.R.C. #544
- Chettleburgh 1984 Held "T" iron as recorded above
- Williams & Works 1985 Held "T" iron, Recorded L.C.R.C. #4368
- Exxel 1987 Held "T" iron as recorded above

B. Description of corner evidence found and/or method applied in restoring or reestablishing corner:


"T" iron as recorded above removed by sewer & street construction
 Reset corner position as recorded above from witnesses and prior surveys by Chettleburgh & Exxel
 The selected location of the corner is 1.23'S and 1.78'E of intersection of 1/4 lines
 Set 4"X30" Harrison Monument at the selected position for the corner

The selected location is accepted by me and is generally accepted by professional Surveyors as the best position of the corner based on the available evidence.

P.A. 345 1990 KENT COUNTY
 PEER APPROVED 12/15/94
 CHAIRMAN *Harry Huber*

C. Description of monument for corner and accessories established to perpetuate locating the position of the corner:

- 4"X30" Harrison Monument
- Nail/tag NW side 18" Ash N32°E 54.57'
- Centerline hydrant N63°E 53.53'
- Nail/tag SW side Power Pole S38°E 54.24'
- Nail/tag SE side 27" Oak S26°W 76.88'
- Nail/tag SW side 18" Maple N52°W 45.67'
- Corner in centerline of East-West pavement, Ada Drive

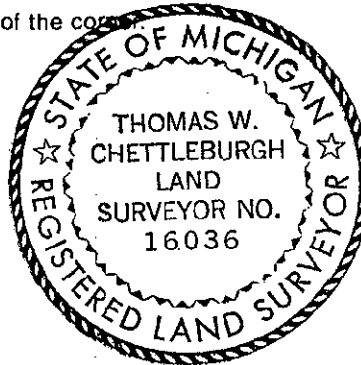

Signed by *Thomas W. Chettleburgh* Date December 27, 1994
 Surveyor's Michigan License No. 16036