

72 SURVEY & REMONUMENTATION

FEB 14 1997

COMMISSION

KENT COUNTY REMONUMENTATION

LAND CORNER RECORDATION CERTIFICATE
Filing Requirement of Act 74, Mich. P.A. 1970

For corners in
KENT COUNTY
(County)

Located In:	Corner Code #
T 7N R 10W	B-13
T R	
T R	
T R	
S T R	
S T R	
S T R	
S T R	

- Public Land Survey
- Property Controlling in Section
- Miscellaneous Property in Sec.

4. Lot No. _____, Recorded Plat _____
5. Private Claims _____

STATE OF MICHIGAN
COUNTY OF KENT
RECEIVED FOR RECORD
96 SEP 13 PM 12:03
REG. OF DEEDS
W. J. [Signature]
9340
Register of Deeds Stamp & File Number

I, Kirk Breitels, in a field survey on June 13, 1996 do hereby state that under requirements of P.A. 74, Michigan P.A. of 1970, the corner points mentioned in lines 1 and 2 above were in conformance with regulations and rules therefore as required in the current manual of survey instructions of the United States Department of the Interior, Bureau of Land Management or by a decree of a Court of Law and for that the corner points mentioned in lines 3, 4 and 5 above were in conformance with the rules of the Michigan Board of Land Surveyors or by a Decree of a Court of Law; established, re-established, monumented, recovered, found as expressed below:

NOTE: Not more than 2 corners, all in the same town and range, may be recorded on this certificate.

	A	B	C	D	E	F	G	H	I	J	K	L	M
1													
2	6	5	4	3	2	1							
3													
4	7	8	9	10	11	12							
5													
6	18	17	16	15	14	13							
7													
8	19	20	21	22	23	24							
9													
10	30	29	28	27	26	25							
11													
12	31	32	33	34	35	36							
13													

P.A. 345 1990 KENT COUNTY
PEER APPROVED 8/22/96
CHAIRMAN [Signature]

A. Description of original monument and accessories and/or subsequent restoration:

B-13	1831	GLO	Mullett	Set Post
	1962	Kent Co. Wit.		1/2" Iron
	1973	LCRC #443	VanKooten	3/4" Iron in Mon. Box
	1981	LCRC #1772	Merdzinski	Set Kent County Monument in Mon. Box
	1988	LCRC #4679	Chettleburgh	Set Kent Co. Mon. after const.
	1989	LCRC #5108	Chettleburgh	Kent County Monument

The position of this corner was previously approved by the Kent County Remonumentation Peer Group, monumented by John A. Merdzinski on 1/30/81 and was recorded per LCRC #1772


B. Description of corner evidence found and/or method applied in restoring or reestablishing corner:

B-13 Found Kent Co. Mon. (Harrison) per wit. from above LCRC as set by Thomas Chettleburgh at the same location as set by John A. Merdzinski in place of the 3/4" Iron over 2 other Irons he found in a Mon. box. All check Kent Co. Wit. and LCRC #443.
LCRC #1772 (Nail/tag in trees) LCRC #4679 & #5108 (Nail/tag in trees-poles)
18" Oak N50°E 46.56' 20" Oak S75°E 33.44' 12" Hickory S54°W 57.32'
14" Maple S50°E 48.81' PP S18°W 78.75' PP S35°E 85.79'
12" Hickory S65°W 57.35' 24" Oak S89°E 62.59'
12" Cherry N40°W 14.35' C/L top hydrant N09°W 111.11'
14" Oak N10°W 29.34' ROW Mon. East 33.05' KC Mon. (B-1, 6-10) West 120.04'

The selected location is accepted by me and is generally accepted by professional surveyors as the best available evidence of the position of the original corner.

C. Description of monument for corner and accessories established to perpetuate locating the position of the corner:

B-13 Standard Kent County Monument		
Set Nail & KC Remon. tag S. side 30" Oak	N85°E	80.65'
Nail & KC Remon. tag NE side P. Pole	S35°E	85.82'
Nail & KC Remon. tag SE side P. Pole	S18°W	78.78'
Nail & KC Remon. tag SE side 12" Hickory	S54°W	57.35'
C/L top of fire hydrant	N09°W	111.29'
Kent Co. Mon. (B-1, T6N, R10W)	West	120.04'

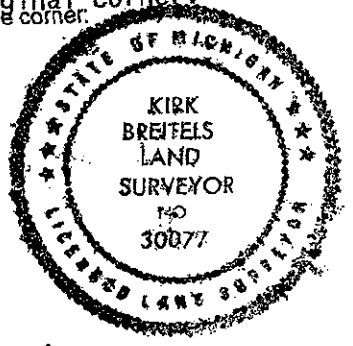

Signed by [Signature]
Surveyor's Michigan License No. 30077

Date 8/25/96