

**SURVEY & REMONUMENTATION**

MAR 03 1998

**LAND CORNER RECORDATION CERTIFICATE**  
**Filing Requirement of Act 74, Mich. P.A. 1970**  
**KENT COUNTY REMONUMENTATION**

For corners in **SECTION**


Kent (County)	Located in: Township	Ada Township	Corner Code #
1. Public Land Survey	T <u>7N</u> R <u>10W</u>		<u>C-1</u>
	T _____ R _____		_____
	T _____ R _____		_____
	T _____ R _____		_____
2. Property Controlling in Section	S _____ T _____ R _____		_____
	S _____ T _____ R _____		_____
3. Miscellaneous Property in Sec.	S _____ T _____ R _____		_____
	S _____ T _____ R _____		_____
4. Lot No. _____, Recorded Plat _____			
5. Private Claims _____			

STATE OF MICHIGAN  
 COUNTY OF KENT  
 RECEIVED FOR RECORD  
 97 OCT 15 AM 8:49  
 REG. OF DEEDS  
*Lucy St. Paul*

10170

Register of Deeds Stamp & File Number

I, Randy Kolehouse, in a field survey on March 31 19 97, do hereby certify that under requirements of P.A. 74 Michigan P.A. of 1970, the corner points mentioned in lines 1 and 2 above were in conformance with regulations and rules therefore as required in the current manual of survey instructions of the United States Department of the Interior, Bureau of Land Management or by a decree of a Court of Law and/or that the corner points mentioned in lines 3, 4 and 5 above were in conformance with the rules of the Michigan Board of Land Surveyors or by a Decree of a Court of Law; established, re-established, monumented, re-monumented, recovered, found as expressed below:

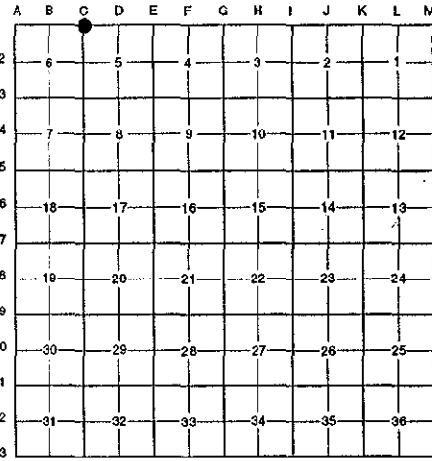

**NOTE: Not more than 4 corners, all in the same town and range, may be recorded on this certificate.**

**A. Description of original monument and accessories and/or subsequent restoration:**

C-1	1831	G.L.O. Notes	Mullett	Set Post
	N/A	Witness Map	K.C. Surveyor	Iron & Stone
	1982	L.C.R.C. #3624	Williams & Works	Iron & Stone / Set "T" Iron
	1984	L.C.R.C. #3957	Exxel Engineering	Fnd. Capped WW Iron / Set K.C. Monument
	1991	L.C.R.C. #6266	Chris Marschall	K.C. Monument

Note: This corner is not common with C-13, T8N, R10W.

This corner was originally approved by the Kent County Remonumentation Peer Group and monumented by Williams & Works on 9/14/84 and was recorded per L.C.R.C. #3957.

**B. Description of corner evidence found and/or method applied in restoring or reestablishing corner:**

C-1 Found a Standard Kent County Monument on the Township line 303.4' West of the C/L intersection of Pettis Avenue (bit.) running North and South and 4 Mile Road (gravel) running East and West, 8.5' South of a downed fence line running East and West, and 20' East of a downed fence line running North and South, per L.C.R.C.'s #3957 and #6266 as set by Exxel Engineering in place of a capped WW iron they found which checked L.C.R.C. #3624 and the K.C. Surveyor's records.

L.C.R.C. #6266

- Nail & Tag N sd. 30" Oak S 70° E 53.85' (m. 53.91')
- Nail & Tag E sd. 14" Walnut S 40° W 23.33' (m. 23.37')
- Nail & Tag E sd. 28" Walnut N 40° W 12.43' (m. 12.42')
- Nail & Tag N sd. 10" Oak S 80° W 15.73' (m. 15.77')
- Nail & Tag W sd. 8" Walnut S 10° E 22.16'

P.A. 345 1990 KENT COUNTY  
 PEER APPROVED 5/22/97  
 CHAIRMAN *Frank Hubert*

The selected location is accepted by me and is generally accepted by professional surveyors as the best available evidence of the position of the original corner.

**C. Description of monument for corner and accessories established to perpetuate locating the position of the corner:**

C-1 Standard Kent County Monument

- Nail & K.C. remon. tag on N side 30" Oak S 70° E 53.91'
- Nail & K.C. remon. tag on E side 14" Walnut S 40° W 23.37'
- Nail & K.C. remon. tag on E side 28" Walnut N 40° W 12.42'
- Nail & K.C. remon. tag on N side 10" Oak S 80° W 15.77'
- Nail & K.C. remon. tag on W side 8" Walnut S 10° E 22.16'
- Nail & K.C. remon. tag on N side 8" Oak S 84° E 13.87'
- K.C. Mon., C-13, T8N, R10W, East 303.41'



Signed by *Randy J. Kolehouse*  
 EARTH TECH

Date 2-1-97

Surveyor's Michigan License No. 25854