

SURVEY & REMONUMENTATION

MAR 03 1998

SECTION

LAND CORNER RECORDATION CERTIFICATE
Filing Requirement of Act 74, Mich. P.A. 1970
KENT COUNTY REMONUMENTATION

For corners in

Kent
 (County)

Located in: Ada Corner Code #
 Township

- | | | |
|------------------------------------|--------------------------|------------|
| 1. Public Land Survey | T <u>7N</u> R <u>10W</u> | <u>C-3</u> |
| | T _____ R _____ | _____ |
| | T _____ R _____ | _____ |
| | T _____ R _____ | _____ |
| 2. Property Controlling in Section | S _____ T _____ R _____ | _____ |
| | S _____ T _____ R _____ | _____ |
| 3. Miscellaneous Property in Sec. | S _____ T _____ R _____ | _____ |
| | S _____ T _____ R _____ | _____ |


STATE OF MICHIGAN
 COUNTY OF KENT
 RECEIVED FOR RECORD
 97 OCT 15 AM 8:49
 REG. OF DEEDS
Tim St. Bond

10172

Register of Deeds Stamp & File Number

4. Lot No. _____, Recorded Plat _____
 5. Private Claims _____

I, Randy Kolehouse, in a field survey on March 31 19 97, do hereby certify that under requirements of P.A. 74 Michigan P.A. of 1970, the corner points mentioned in lines 1 and 2 above were in conformance with regulations and rules therefore as required in the current manual of survey instructions of the United States Department of the interior, Bureau of Land Management or by a decree of a Court of Law and/or that the corner points mentioned in lines 3, 4 and 5 above were in conformance with the rules of the Michigan Board of Land Surveyors or by a Decree of a Court of Law; established, re-established, monumented, re-monumented, recovered, found as expressed below:

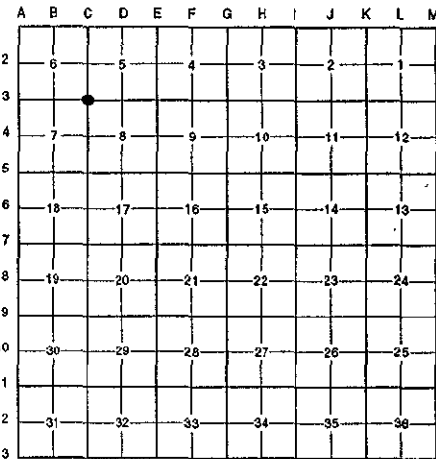

NOTE: Not more than 4 corners, all in the same town and range, may be recorded on this certificate.

A. Description of original monument and accessories and/or subsequent restoration:

C-3	1831	G.L.O. Notes	Mullett	Set Post	P.A. 345 1990 KENT COUNTY
	1942	Witness Map	K.C. Surveyor	1" Iron	PEER APPROVED 5/1/97
	1972	L.C.R.C. #121	Williams & Works	1" Iron	CHAIRMAN <i>Harry Hubert</i>
	1982	L.C.R.C. #3152	G. Hackbardt	Fnd. 1" Iron / Set K.C. Monument	
	1989	L.C.R.C. #5110	T. Chettleburgh	K.C. Monument	

This corner was originally approved by the Kent County Remonumentation Peer Group and monumented by G. Hackbardt on 6/15/82 and was recorded per L.C.R.C. #3152.

B. Description of corner evidence found and/or method applied in restoring or reestablishing corner:

C-3 Found a Standard Kent County Monument at the C/L of 3 Mile Road (gravel) running East and 4.8' East of the C/L of Pettis Avenue (bit.) running North and South per L.C.R.C.'s #3152 and #5110 as set by G. Hackbardt in place of a 1" iron he found which checked L.C.R.C. #121 and the K.C. Surveyor's records.

L.C.R.C. #3152

- K.C. Nail & tag 28" Poplar S 15° W 72.95'
- K.C. Nail & tag 20" Poplar S 85° W 27.98'
- K.C. Nail & tag 6" Ash N 45° W 36.00'
- K.C. Nail & tag MBT Pole N 45° E 69.50'

L.C.R.C. #5110

- K. C. Remon. Tag & Nail Southeast side Telephone Pole N 51° E 69.40' (m. 69.43')
- K. C. Remon. Tag & Nail East side 24" Hickory S 18° E 81.54' (m. 81.58')
- K. C. Remon. Tag & Nail East side 32" Poplar S 22° W 72.98' (m. 72.99')
- K. C. Remon. Tag & Nail Southeast side 23" Poplar S 85° W 27.95'
- K. C. Remon. Tag & Nail Southwest side 11" Ash N 43° W 36.00'

The selected location is accepted by me and is generally accepted by professional surveyors as the best available evidence of the position of the original corner.

C. Description of monument for corner and accessories established to perpetuate locating the position of the corner:

C-3 Standard Kent County Monument

- Nail & K.C. remon. tag on SE side T. pole N 51° E 69.43'
- Nail & K.C. remon. tag on E side 24" Hickory S 18° E 81.58'
- Two Nail & K.C. remon. tags on E side 32" Poplar S 22° W 72.99'
- Nail & K.C. remon. tag on SW side 10" Ash N 43° W 36.00'
- Nail & K.C. remon. tag on SE side 26" Poplar S 85° W 27.95'



Signed by *Randy J. Kolehouse* Date 8-1-97
 EARTH TECH

Surveyor's Michigan License No. 25854