

SURVEY & REMONUMENTATION

MAR 03 1998

SECTION

LAND CORNER RECORDATION CERTIFICATE
Filing Requirement of Act 74, Mich. P.A. 1970
KENT COUNTY REMONUMENTATION

For corners in

Kent
 (County)

Located in: Ada
 Township

Corner Code #

- 1. Public Land Survey T 7N R 10W C-8
 T _____ R _____
 T _____ R _____
 T _____ R _____
- 2. Property Controlling in Section S _____ T _____ R _____
 S _____ T _____ R _____
- 3. Miscellaneous Property in Sec. S _____ T _____ R _____
 S _____ T _____ R _____
- 4. Lot No. _____, Recorded Plat _____
- 5. Private Claims _____


REG. OF DEEDS
David Bond
 97 OCT 15 AM 8:49
 STATE OF MICHIGAN
 COUNTY OF KENT
 RECEIVED FOR RECORD

10176

Register of Deeds Stamp & File Number

I, Randy Kolehouse, in a field survey on January 23 19 97, do hereby certify that under requirements of P.A. 74 Michigan P.A. of 1970, the corner points mentioned in lines 1 and 2 above were in conformance with regulations and rules therefore as required in the current manual of survey instructions of the United States Department of the interior, Bureau of Land Management or by a decree of a Court of Law and/or that the corner points mentioned in lines 3, 4 and 5 above were in conformance with the rules of the Michigan Board of Land Surveyors or by a Decree of a Court of Law; established, re-established, monumented, re-monumented, recovered, found as expressed below:

NOTE: Not more than 4 corners, all in the same town and range, may be recorded on this certificate.

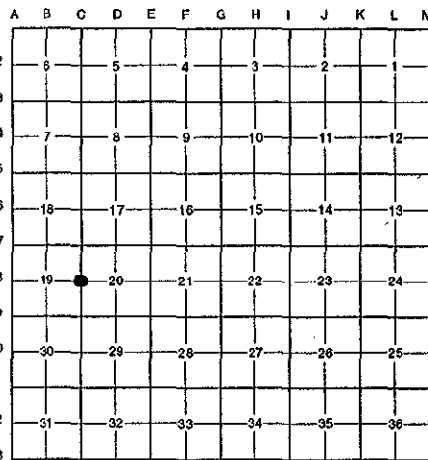

A. Description of original monument and accessories and/or subsequent restoration:

C-8	1831	G.L.O. Notes	Mullett	Set Post	P.A. 345 1990 KENT COUNTY
	N/A	Witness Map	K.C. Surveyor	Iron	PEER APPROVED <u>5/22/97</u>
	1983	L.C.R.C. #3712	Moore & Bruggink	"T" Iron	<i>CHAIRMAN Randy Kolehouse</i>
	1984	L.C.R.C. #3923	Moore & Bruggink	Fnd. "T" Iron / Set K.C. Monument	
	1989	L.C.R.C. #5114	T. Chettleburgh	K.C. Monument	

This corner was originally approved by the Kent County Remonumentation Peer Group and monumented by J. McCloskey on 10/5/84 and was recorded per L.C.R.C. #3923.

B. Description of corner evidence found and/or method applied in restoring or reestablishing corner:

C-8 Found a Standard Kent County Monument on line of a fence line and tree row running East and West and the West edge of a farm drive running North and South per L.C.R.C.'s #3923 and #5114 as set by Moore & Bruggink in place of a "T" iron they found which checked L.C.R.C. #3712 and the K.C. Surveyor's records.

L.C.R.C. #3923

L.C.R.C. #5114

- Nail in 38" Oak N 70° E 127.24'
- Nail in 28" Ash S 85° E 201.84'
- Nail in Fence Post W 1.06'
- Nail in twin twin 6" Thornapple 30.72'

- K.C. Remon. Tag & Nail Northeast 28" Oak N 50° E 187.49' (m. 187.52')
- K.C. Remon. Tag & Nail South side 40" Oak N 70° E 127.21' (m. 127.26')
- K.C. Remon. Tag & Nail South side 34" Hickory S 84° E 201.67'
- K.C. Remon. Tag & Nail North side Twin 6" Thorn Apple N 90° W 30.67'
- K.C. Remon. Tag & Nail North side 18" Oak N 87° W 73.35'
- K.C. Remon. Tag & Nail South side Fence Post N 73° W 1.01' (m. 1.30')

The selected location is accepted by me and is generally accepted by professional surveyors as the best available evidence of the position of the original corner.

C. Description of monument for corner and accessories established to perpetuate locating the position of the corner:

C-8 Standard Kent County Monument

- Nail & K.C. remon. tag on NW side 30" Oak N 50° E 187.52'
- Nail & K.C. remon. tag on S side 40" Oak N 70° E 127.26'
- Nail & K.C. remon. tag on S side 34" Hickory S 84° E 201.67'
- Nail & K.C. remon. tag on N side Twin 8" Thornapple N 90° W 30.67'
- Nail & K.C. remon. tag on N side 18" Oak N 87° W 73.35'
- Nail & K.C. remon. tag on S side leaning fence post N 73° W 1.30'



Signed by *Randy J. Kolehouse* Date 8-1-97

Surveyor's Michigan License No. 25854