

# SURVEY & REMONUMENTATION

MAR 03 1998

## LAND CORNER RECORDATION CERTIFICATE Filing Requirement of Act 74, Mich. P.A. 1970 KENT COUNTY REMONUMENTATION

### SECTION


For corners in

Kent (County)	Located in: Township	Ada	Corner Code #
1. Public Land Survey	T <u>7N</u>	R <u>10W</u>	<u>C-10</u>
	T _____	R _____	_____
	T _____	R _____	_____
	T _____	R _____	_____
2. Property Controlling in Section	S _____	T _____	R _____
	S _____	T _____	R _____
3. Miscellaneous Property in Sec.	S _____	T _____	R _____
	S _____	T _____	R _____

STATE OF MICHIGAN  
COUNTY OF KENT  
RECEIVED FOR RECORD  
97 OCT 15 AM 8:49  
REG. OF DEEDS  
*Luci Bond*  
**10178**  
Register of Deeds Stamp & File Number

4. Lot No. \_\_\_\_\_, Recorded Plat \_\_\_\_\_  
5. Private Claims \_\_\_\_\_

I, Randy Kolehouse, in a field survey on January 22 19 97, do hereby certify that under requirements of P.A. 74 Michigan P.A. of 1970, the corner points mentioned in lines 1 and 2 above were in conformance with regulations and rules therefore as required in the current manual of survey instructions of the United States Department of the interior, Bureau of Land Management or by a decree of a Court of Law and/or that the corner points mentioned in lines 3, 4 and 5 above were in conformance with the rules of the Michigan Board of Land Surveyors or by a Decree of a Court of Law; established, re-established, monumented, re-monumented, recovered, found as expressed below:

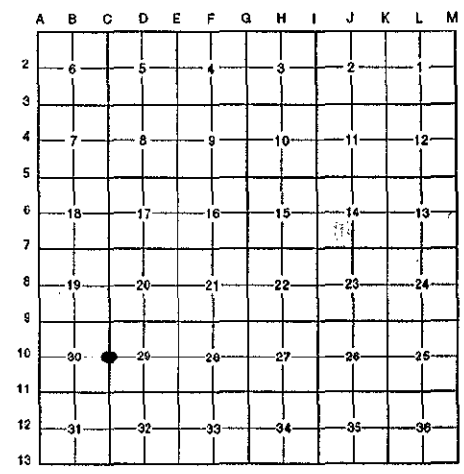

**NOTE: Not more than 4 corners, all in the same town and range, may be recorded on this certificate.**

**A. Description of original monument and accessories and/or subsequent restoration:**

C-10	1831	G.L.O. Notes	Mullett	Set Post
	1956	Witness Map	K.C. Surveyor	Iron
	1981	L.C.R.C. #1614	Medema, Van Kooten & Assoc.	Set Capped Iron
	1982	L.C.R.C. #2966	Williams & Works	Fnd. Capped Iron / Set K.C. Monument
	1989	L.C.R.C. #5116	T. Chettleburgh	K.C. Monument

This corner was originally approved by the Kent County Remonumentation Peer Group and monumented by Williams & Works on 5/27/82 and was recorded per L.C.R.C. #2966.

**B. Description of corner evidence found and/or method applied in restoring or reestablishing corner:**

C-10 Found a Standard Kent County Monument 36' North of the C/L of westbound M-21 (bit.) per L.C.R.C.'s #2966 and #5116 as set by Williams & Works in place of a capped iron they found which checked L.C.R.C. #1614 and the K.C. Surveyor's records.

L.C.R.C. #2966

L.C.R.C. #5116

Nail & K.C. Remon. tag in SW side T. Pole N 45° W 70.7'  
Nail & K.C. Remon. tag in SE side 16" Oak N 30° E 68.35'  
Top East end concrete driveway culvert West 213.20'  
Centerline west bound lane of M-21 is 36.0' South of corner

K.C. Remon. Tag & Nail Southeast side 18" Oak N 45° E 68.37' (m. 68.33')  
K.C. Remon. Tag & Nail North side 12" Oak S 87° E 255.88' (m. 255.96')  
K.C. Remon. Tag & Nail East side Power Pole S 16° E 231.84'  
Centerline west bound lane of M-21 South 35.8'  
Top East end concrete driveway culvert N 84° W 213.22' (m. 213.33')  
K.C. Remon. Tag & Nail South side 14" Pine N 75° W 123.05'  
K.C. Remon. Tag & Nail Southwest side Telephone Pole N 51° W 70.31' (m. 70.24')


The selected location is accepted by me and is generally accepted by professional surveyors as the best available evidence of the position of the original corner.

**C. Description of monument for corner and accessories established to perpetuate locating the position of the corner:**

C-10 Standard Kent County Monument  
Nail & K.C. remon. tag on SE side 18" Oak N 45° E 68.33'  
Nail & K.C. remon. tag on N side 12" Oak S 87° E 255.96'  
Nail & K.C. remon. tag on E side P. pole S 16° E 231.84'  
Nail & K.C. remon. tag on SW side T. pole N 51° W 70.24'  
Top E end conc. driveway culvert N 84° W 213.33'

P.A. 345 1990 KENT COUNTY,

PEER APPROVED 5/22/97  
CHAIRMAN *Harry Hubel*

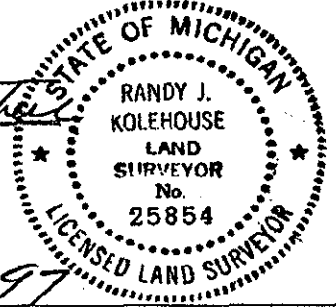

Signed by Randy J. Kolehouse  
EARTH TECH

Date 8-1-97

Surveyor's Michigan License No. 25854