

SURVEY & REMONUMENTATION

MAR 03 1998

LAND CORNER RECORDATION CERTIFICATE Filing Requirement of Act 74, Mich. P.A. 1970 KENT COUNTY REMONUMENTATION

\$7.00
\$2.00

For corners in

SECTION

Kent <small>(County)</small>	Located in: Ada <small>Township</small>	Corner Code #	
1. Public Land Survey	T <u>7N</u> R <u>10W</u>	<u>C-11</u>	
	T _____ R _____	_____	
	T _____ R _____	_____	
	T _____ R _____	_____	
2. Property Controlling in Section	S _____ T _____ R _____	_____	
	S _____ T _____ R _____	_____	
3. Miscellaneous Property in Sec.	S _____ T _____ R _____	_____	
	S _____ T _____ R _____	_____	
4. Lot No. _____, Recorded Plat _____			
5. Private Claims _____			

REG. OF DEEDS
 97 NOV 14 AM 9:00
 STATE OF MICHIGAN
 COUNTY OF KENT
 RECEIVED FOR RECORD
10310
 Register of Deeds Stamp & File Number

I, Randy Kolehouse, in a field survey on August 5 19 97, do hereby certify that under requirements of P.A. 74 Michigan P.A. of 1970, the corner points mentioned in lines 1 and 2 above were in conformance with regulations and rules therefore as required in the current manual of survey instructions of the United States Department of the interior, Bureau of Land Management or by a decree of a Court of Law and/or that the corner points mentioned in lines 3, 4 and 5 above were in conformance with the rules of the Michigan Board of Land Surveyors or by a Decree of a Court of Law; established, re-established, monumented, re-monumented, recovered, found as expressed below:

NOTE: Not more than 4 corners, all in the same town and range, may be recorded on this certificate.

A. Description of original monument and accessories and/or subsequent restoration:

C-11	1831	G.L.O. Notes	Mullett	Set Post
	1963	Witness Map	K.C. Surveyor	Stone
	1971	L.C.R.C. #11	J. Spencer	"T" Iron and Stone
	1980	L.C.R.C. #1492	Williams & Works	Fnd. "T" Iron / Set K.C. Monument in Ring of Stones
	1989	L.C.R.C. #5117	T. Chettleburgh	K.C. Monument in Ring of Stones

This corner was originally approved by the Kent County Remonumentation Peer Group and monumented by Williams & Works on 12/3/80 and was recorded per L.C.R.C. #1492.

B. Description of corner evidence found and/or method applied in restoring or reestablishing corner:

C-11 Found a Standard Kent County Monument in a fence line running East and West and 18' East of an old fence line running South per L.C.R.C.'s #1492 and #5117 as set by Williams & Works in place of a "T" iron they found surrounded by stones which checked L.C.R.C. #11 and the K.C. Surveyor's records.

L.C.R.C. #1492

L.C.R.C. #5117

Nail & K.C. Remon. Tag South Side 14" Oak East 3.59'	3/4" Iron East 2.95'± And South 0.90'±
Nail & K.C. Remon. Tag N'y Side 1'4" Wild Cherry S 55°W 23.11'	K.C. Remon. Tag & Nail South side 18" Oak N 81° E 3.59' (m. 3.63')
Nail & K.C. Remon. Tag W'y Side 18" Oak S 10°W 19.00'	K.C. Remon. Tag & Nail North side 8" Cherry S 59° E 28.36' (m. 28.45')
Nail & K.C. Remon. Tag E'y Side 8" Wild Cherry S 35°E 30.00'	K.C. Remon. Tag & Nail East side 19" Wild Cherry S 30° E 29.91' (m. 29.95')
Nail & K.C. Remon. Tag E'y Side 6" Maple S 25°W 9.95'	K.C. Remon. Tag & Nail West side 20" Oak S 15° W 19.06' (m. 19.10')
3/4" Iron East 2.95'± & South .90'±, Fence South is West 18'±, Cor. is. in E-W Fence	K.C. Remon. Tag & Nail East side 7" Maple S 31° W 9.95'
	K.C. Remon. Tag & Nail North side 16" Wild Cherry S 60° W 23.44' (m. 23.50')
	Fence South West 18'±

The selected location is accepted by me and is generally accepted by professional surveyors as the best available evidence of the position of the original corner.

C. Description of monument for corner and accessories established to perpetuate locating the position of the corner:

C-11 Standard Kent County Monument

Nail & K.C. remon. tag on S side 20" Black Oak S 85° E 3.63'

Nail & K.C. remon. tag on NE side 9" Cherry S 58° E 28.45'

Nail & K.C. remon. tag on NE side 12" Cherry S 29° E 29.95'


Nail & K.C. remon. tag on W side 24" Black Oak S 17° W 19.10'

Nail & K.C. remon. tag on E side 8" Maple S 31° W 16.90'

Nail & K.C. remon. tag on N side 18" Cherry S 62° W 23.50'

3/4" iron S 65° E 3.35'

P.A. 345 1990 KENT COUNTY
PEER APPROVED 9/23/97
CHAIRMAN Randy Kolehouse

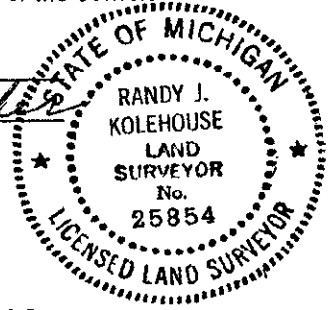

Signed by Randy J. Kolehouse Date 9/23/97
EARTH TECH

Surveyor's Michigan License No. 25854