

**SURVEY & REMONUMENTATION**

**MAR 03 1998**

**SECTION**

**LAND CORNER RECORDATION CERTIFICATE**  
**Filing Requirement of Act 74, Mich. P.A. 1970**  
**KENT COUNTY REMONUMENTATION**

For corners in

Kent (County)	Located in:	Ada Township	Corner Code #
1. Public Land Survey	T <u>7N</u>	R <u>10W</u>	<u>C-12</u>
	T _____	R _____	_____
	T _____	R _____	_____
	T _____	R _____	_____
2. Property Controlling in Section	S _____	T _____	R _____
	S _____	T _____	R _____
3. Miscellaneous Property in Sec.	S _____	T _____	R _____
	S _____	T _____	R _____

REG. OF DEEDS

*Handwritten signature*


97 OCT 15 AM 8:50

STATE OF MICHIGAN  
 COUNTY OF KENT  
 RECEIVED FOR RECORD

**10179**

Register of Deeds Stamp & File Number

4. Lot No. \_\_\_\_\_, Recorded Plat \_\_\_\_\_  
 5. Private Claims \_\_\_\_\_

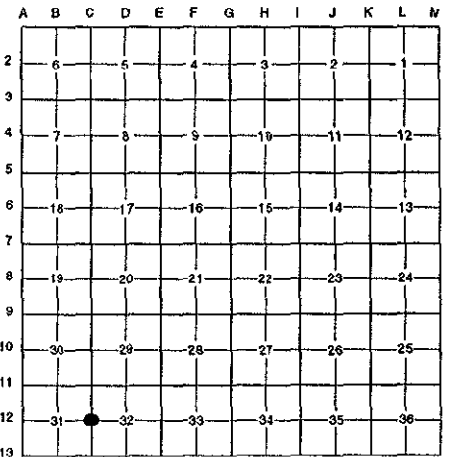

I, Randy Kolehouse, in a field survey on January 15 19 97, do hereby certify that under requirements of P.A. 74 Michigan P.A. of 1970, the corner points mentioned in lines 1 and 2 above were in conformance with regulations and rules therefore as required in the current manual of survey instructions of the United States Department of the interior, Bureau of Land Management or by a decree of a Court of Law and/or that the corner points mentioned in lines 3, 4 and 5 above were in conformance with the rules of the Michigan Board of Land Surveyors or by a Decree of a Court of Law; established, re-established, monumented, re-monumented, recovered, found as expressed below:

**NOTE: Not more than 4 corners, all in the same town and range, may be recorded on this certificate.**

**A. Description of original monument and accessories and/or subsequent restoration:**

C-12	1831	G.L.O. Notes	Mullett	Set Post
	1953	Witness Map	K.C. Surveyor	Iron in Monument Box
	1973	L.C.R.C. #592	Exxel Engineering	3/4" Iron
	1975	L.C.R.C. #865	Medema, Van Kooten & Assoc.	1-1/2" Iron
	1982	L.C.R.C. #3143	Moore & Bruggink	Fnd. 3/4" Iron / Set K.C. Monument
	1989	L.C.R.C. #5118	T. Chettleburgh	K.C. Monument

This corner was originally approved by the Kent County Remonumentation Peer Group and monumented by Moore & Bruggink on 8/30/82 and was recorded per L.C.R.C. #3143.

**B. Description of corner evidence found and/or method applied in restoring or reestablishing corner:**

C-12 Found a Standard Kent County Monument on the C/L of Ada Drive (bit.) running East and West on line of a tree row running North and South per L.C.R.C.'s #3143 and #5118 as set by Moore & Bruggink in place of a 3/4" iron they found which checked L.C.R.C.'s #865, #592 and the K.C. Surveyor's records.

**L.C.R.C. #3143**

- K.C. Nail & Tag 16" Oak S 60° W 58.23'
- K.C. Nail & Tag 24" Oak S 60° E 63.33'
- K.C. Nail & Tag 18" Oak S 30° E 32.74'
- K.C. Nail & Tag 12" Oak S 05° W 46.42'

**L.C.R.C. #5118**


- K.C. Remon. Tag & Nail West side 19" Hickory N 08° E 28.09'
- Centerline Hydrant N 70° E 65.14'
- K.C. Remon. Tag & Nail Northeast side 19" Oak S 24° E 32.60' (m. 32.45')
- K.C. Remon. Tag & Nail West side 12" Oak S 08° W 46.46' (m. 46.45')
- K.C. Remon. Tag & Nail Northwest side 16" Oak S 55° W 58.38' (m. 59.15')

The selected location is accepted by me and is generally accepted by professional surveyors as the best available evidence of the position of the original corner.

**C. Description of monument for corner and accessories established to perpetuate locating the position of the corner:**

**C-12 Standard Kent County Monument**

- Nail & K.C. remon. tag on W side 19" Hickory N 08° E 28.09'
- Nail & K.C. remon. tag on NE side 19" Oak S 24° E 32.45'
- Nail & K.C. remon. tag on W side 14" Oak S 08° W 46.45'
- Nail & K.C. remon. tag on NW side 18" Oak S 55° W 59.15'
- Center line hyd. N 70° E 65.14'

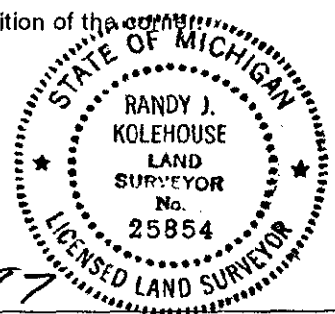

Signed by Randy J. Kolehouse Date 8-1-97

EARTH TECH

Surveyor's Michigan License No. 25854

P.A. 345 1990 KENT COUNTY

PEER APPROVED 5/22/97

CHAIRMAN Harry Hubert