

SURVEY & REMONUMENTATION

MAR 03 1998

LAND CORNER RECORDATION CERTIFICATE Filing Requirement of Act 74, Mich. P.A. 1970 KENT COUNTY REMONUMENTATION

\$7.00
\$2.00

For corners in SECTION _____

Kent (County)	Located in:	Ada Township	Corner Code #
1. Public Land Survey	T <u>7N</u>	R <u>10W</u>	<u>D-1</u>
	T _____	R _____	_____
	T _____	R _____	_____
	T _____	R _____	_____
2. Property Controlling in Section	S _____	T _____	R _____
	S _____	T _____	R _____
3. Miscellaneous Property in Sec.	S _____	T _____	R _____
	S _____	T _____	R _____

4. Lot No. _____, Recorded Plat _____
5. Private Claims _____

STATE OF MICHIGAN
COUNTY OF KENT
RECEIVED FOR RECORD


97 DEC 15 AM 10:41

REG. OF DEEDS

10355

Register of Deeds Stamp & File Number

I, Randy Kolehouse, in a field survey on June 5 19 97, do hereby certify that under requirements of P.A. 74 Michigan P.A. of 1970, the corner points mentioned in lines 1 and 2 above were in conformance with regulations and rules therefore as required in the current manual of survey instructions of the United States Department of the interior, Bureau of Land Management or by a decree of a Court of Law and/or that the corner points mentioned in lines 3, 4 and 5 above were in conformance with the rules of the Michigan Board of Land Surveyors or by a Decree of a Court of Law; established, re-established, monumented, re-monumented, recovered, found as expressed below:

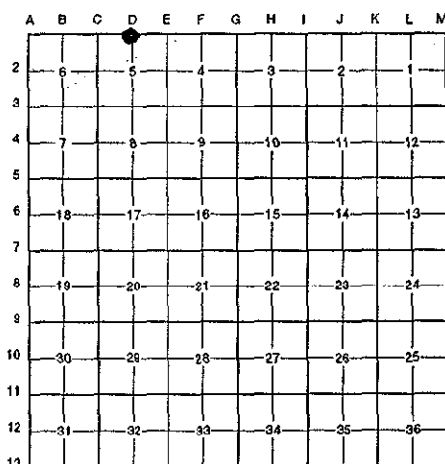

NOTE: Not more than 4 corners, all in the same town and range, may be recorded on this certificate.

A. Description of original monument and accessories and/or subsequent restoration:

D-1 This corner was not originally set by the G.L.O.

N/A	Witness Map	K.C. Surveyor	Iron & Stone
1971	L.C.R.C. #61	M. Chambers	1" Iron & Stone
1985	L.C.R.C. #4052	Exxel Engineering	Fnd. Iron in Stone / Set K.C. Monument
1991	L.C.R.C. #6264	Chris Marschall	K.C. Monument

P.A. 345 1990 KENT COUNTY
PEER APPROVED 6/26/97
CHAIRMAN Harry Huber

Note: This corner is not common with D-13, T8N, R10W.

This corner was originally approved by the Kent County Remonumentation Peer Group and monumented by Exxel Engineering on 1/3/85 and was recorded per L.C.R.C. #4052.

B. Description of corner evidence found and/or method applied in restoring or reestablishing corner:

D-1 Found a Standard Kent County Monument on the Township line 200' ± North of the C/L of 4 Mile Road (gravel) running East and West per L.C.R.C.'s #4052 and #6264 as set by Exxel Engineering in place of a iron in stone they found which checked L.C.R.C. #6264 and the K.C. Surveyor's records.

L.C.R.C. #4052

L.C.R.C. #6264

Name & remon. tag in NE sde 17" Oak N 40° W 26.23'	Nail & Tag W sd. Twin 8"-6" Oak (6' above ground) S 05 W 31.28'
	Nail & Tag SE sd. 8" Oak (4' above ground) S 50 W 35.16'
	Nail & Tag S sd. 8" Oak S 75° W 10.90'

The selected location is accepted by me and is generally accepted by professional surveyors as the best available evidence of the position of the original corner.

C. Description of monument for corner and accessories established to perpetuate locating the position of the corner:

D-1 Standard Kent County Monument

- Nail & K.C. remon. tag on E side 8" B. Oak N 16° E 18.6'
- Nail & K.C. remon. tag on W side 16" B. Oak S 10° W 31.28'
- Nail & K.C. remon. tag on SE 8" W. Oak S 45° W 35.20'
- Nail & K.C. remon. tag on S side 8" W. Oak S 78° W 10.9'
- Nail & K.C. remon. tag on NE side 18" B. Oak N 36° W 26.28'
- K.C. Mon., D-13, T8N, R10W, East 284.12'

Signed by Randy J. Kolehouse Date 11/20/97
EARTH TECH
Surveyor's Michigan License No. 25854

