

SURVEY & REMONUMENTATION

APR 28 1995

COMMISSION

LAND CORNER RECORDATION CERTIFICATE
Filing Requirement of Act 74, Mich. P.A. 1970

STATE OF MICHIGAN
COUNTY OF KENT
RECEIVED FOR RECORD
94 DEC 28 PM 3:04

For corners in

| | | |
|------------------------------------|--------------------------|---------------|
| <u>Kent</u> (County) | Located In: | Corner Code # |
| Ada Township | T <u>7N</u> R <u>10W</u> | D-2 |
| 1. Public Land Survey | T _____ R _____ | Center |
| | T _____ R _____ | Section 5 |
| | T _____ R _____ | |
| | T _____ R _____ | |
| 2. Property Controlling in Section | S _____ T _____ R _____ | |
| | S _____ T _____ R _____ | |
| 3. Miscellaneous Property in Sec. | S _____ T _____ R _____ | |
| | S _____ T _____ R _____ | |


Luigi J. Bond
REG. OF DEEDS

7927

Register of Deeds Stamp & File Number

4. Lot No. _____, Recorded Plat _____
5. Private Claims _____

Thomas W. Chettleburgh, in a field survey on December 14, 1994, do hereby certify that under requirements of P.A. 74, Michigan P.A. of 1970, the corner points mentioned in lines 1 and 2 above were in conformance with regulations and rules therefore as required in the current manual of survey instructions of the United States Department of the Interior, Bureau of Land Management or by a decree of a Court of Law and/or that the corner points mentioned in lines 3, 4 and 5 above were in conformance with the rules of the Michigan Board of Land Surveyors or by a Decree of a Court of Law; established, re-established, monumented, re-monumented, recovered, found as expressed below:

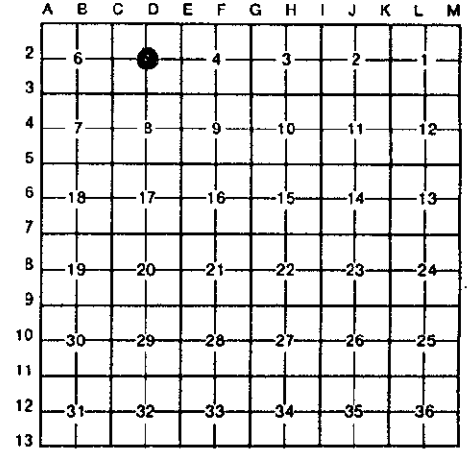

NOTE: Not more than 4 corners, all in the same town and range, may be recorded on this certificate.

- A. Description of original monument and accessories and/or subsequent restoration:
- | | | |
|---|------|--|
| Corner Post not set by U.S. Government land Surveys | | |
| Williams & Works | 1893 | Set stone at intersection of 1/4 lines |
| Williams & Works | 1951 | Found stone and held for center |
| Glaza | 1979 | Held intersection of 1/4 lines |
| Nederveld | 1983 | Held intersection of 1/4 lines |
| Van Kooten | 1987 | Held intersection of 1/4 lines |

- B. Description of corner evidence found and/or method applied in restoring or reestablishing corner:
- Hold intersection of 1/4 lines for corner
 - Stone as set in 1893 and held in 1951 was not recovered
 - Set 4"X30" Harrison Monument

The selected location is accepted by me and is generally accepted by Professional surveyors as the best position of the corner based on the available evidence.

P.A. 345 1990 KENT COUNTY
PEER APPROVED 12/22/94
CHAIRMAN *Fanny Huber*

- C. Description of monument for corner and accessories established to perpetuate locating the position of the corner:

| | | | | |
|--------------------------|---------|-----------|-------|--------|
| 4"X30" Harrison Monument | | | | |
| Nail/tag | SE side | 11" Elm | N45°E | 30.77' |
| Nail/tag | N side | 17" Maple | N82°E | 35.87' |
| Nail/tag | SW side | 7" Elm | S45°E | 7.26' |
| Nail/tag | SE side | 19" Maple | S73°W | 42.18' |
| Nail/tag | SW side | 20" Maple | N70°W | 25.67' |



Signed by *Thomas W. Chettleburgh*
Surveyor's Michigan License No. 16036

Date December 27, 1994