

MAR 03 1998

SECTION

LAND CORNER RECORDATION CERTIFICATE
Filing Requirement of Act 74, Mich. P.A. 1970
KENT COUNTY REMONUMENTATION

STATE OF MICHIGAN
 COUNTY OF KENT
 RECEIVED FOR RECORD
 97 OCT 15 AM 8:50
 REG. OF DEEDS
Lucy Bond

For corners in Kent (County) Located in: Ada Township Corner Code # _____


1. Public Land Survey	T <u>7N</u>	R <u>10W</u>	<u>D-5</u>
	T _____	R _____	_____
	T _____	R _____	_____
	T _____	R _____	_____
2. Property Controlling in Section	S _____	T _____	R _____
	S _____	T _____	R _____
3. Miscellaneous Property in Sec.	S _____	T _____	R _____
	S _____	T _____	R _____

4. Lot No. _____, Recorded Plat _____

5. Private Claims _____

10181
 Register of Deeds Stamp & File Number

I, Randy Kolehouse, in a field survey on March 31 19 97, do hereby certify that under requirements of P.A. 74 Michigan P.A. of 1970, the corner points mentioned in lines 1 and 2 above were in conformance with regulations and rules therefore as required in the current manual of survey instructions of the United States Department of the Interior, Bureau of Land Management or by a decree of a Court of Law and/or that the corner points mentioned in lines 3, 4 and 5 above were in conformance with the rules of the Michigan Board of Land Surveyors or by a Decree of a Court of Law; established, re-established, monumented, re-monumented, recovered, found as expressed below:

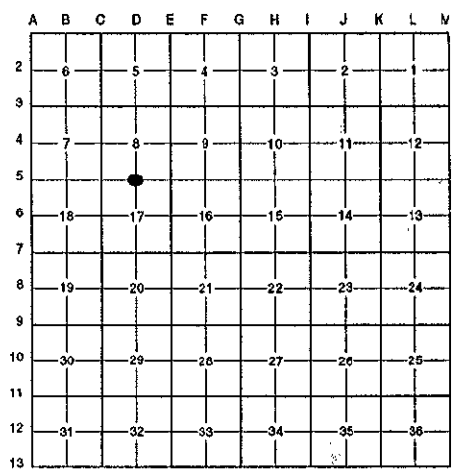

NOTE: Not more than 4 corners, all in the same town and range, may be recorded on this certificate.

A. Description of original monument and accessories and/or subsequent restoration:

D-5	1831	G.L.O. Notes	Mullett	Set Post
	1963	Witness Map	K.C. Surveyor	Iron
	1973	L.C.R.C. #367	J. Clapp	1" Iron Pipe
	1981	L.C.R.C. #2551	J. Bueche	Fnd. 1" x 18" Iron / Set K.C. Monument
	1989	L.C.R.C. #5121	T. Chettleburgh	K.C. Monument

This corner was originally approved by the Kent County Remonumentation Peer Group and monumented by J. Bueche on 12/12/81 and was recorded per L.C.R.C. #2551.

B. Description of corner evidence found and/or method applied in restoring or reestablishing corner:

D-5 Found a Standard Kent County Monument in the C/L of 2 Mile Road (gravel) running East and West on line of a tree row running South per L.C.R.C.'s #2551 and #5121 as set by J. Bueche in place of a 1" x 18" iron he found which checked L.C.R.C. #367 and the K.C. Surveyor's records.

<p>L.C.R.C. #2551</p> <p>K.C. Remon. tag & nail in North side 14" Oak S 80° E 67.42'</p> <p>K.C. Remon. tag & nail in North side 14" double Oak N 60° E 36.83'</p> <p>K.C. Remon. tag & nail in West side 16" double Oak N 00° E 42.55'</p> <p>K.C. Remon. tag & nail in North side 8" W. Cherry S 75° W 72.67'</p> <p>K.C. Remon. tag & nail in fence post for gate S 40° E 44.25'</p> <p>On C/L gravel E & W</p> <p>Tree row South</p> <p>C/L dr. North is West 11' M/L</p> <p>C/L dr. South is East 17' M/L</p>	<p>L.C.R.C. #5121</p> <p>K.C. Remon. Tag & Nail in N side 14" Oak S 72° E 67.37' (m. 67.39')</p> <p>K.C. Remon. Tag & Nail in N side 15" Twin Oak N 61° E 36.78'</p> <p>K.C. Remon. Tag & Nail in W side 16" Twin Oak N 02° E 42.51'</p> <p>K.C. Remon. Tag & Nail in N side 8" W. Cherry S 76° W 72.61' (m. 72.63')</p> <p>K.C. Remon. Tag & Nail in fence post for gate S 39° E 44.24' (m. 44.26')</p> <p>K.C. Remon. Tag & Nail in NE side 22" Oak S 36° E 95.37'</p> <p>C/L drive North West 11' ±</p> <p>C/L drive South East 17' ±</p> <p>Tree row South</p>
--	--

The selected location is accepted by me and is generally accepted by professional surveyors as the best available evidence of the position of the original corner.

C. Description of monument for corner and accessories established to perpetuate locating the position of the corner:

D-5 Standard Kent County Monument

Nail & K.C. remon. tag on N side 14" Oak S 72° E 67.39'


Nail & K.C. remon. tag on N side 16" Twin Oak N 61° E 36.78'

Nail & K.C. remon. tag on W side 16" Twin Oak N 02° E 42.51'

Nail & K.C. remon. tag on N side 8" Wild Cherry S 76° W 72.63'

Nail & K.C. remon. tag on NE side fence cor. post S 39° E 44.26'

Nail & K.C. remon. tag on NE side 22" Oak S 36° E 95.37'

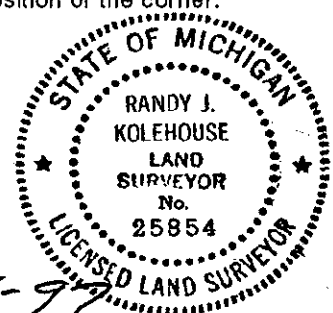

Signed by Randy J. Kolehouse Date 8-1-97

Surveyor's Michigan License No. 25854

P.A. 345 1990 KENT COUNTY
 PEER APPROVED 5/22/97
 CHAIRMAN Harry Hubert