

**SURVEY & REMONUMENTATION**

**MAR 03 1998**

**LAND CORNER RECORDATION CERTIFICATE**  
**Filing Requirement of Act 74, Mich. P.A. 1970**  
**KENT COUNTY REMONUMENTATION**

For corners in **SECTION**  
Kent  
 (County)

Located in: Ada Township Corner Code #  
 T 7N R 10W D-9  
 T \_\_\_\_\_ R \_\_\_\_\_  
 T \_\_\_\_\_ R \_\_\_\_\_  
 T \_\_\_\_\_ R \_\_\_\_\_  
 2. Property Controlling in Section S \_\_\_\_\_ T \_\_\_\_\_ R \_\_\_\_\_  
 S \_\_\_\_\_ T \_\_\_\_\_ R \_\_\_\_\_  
 3. Miscellaneous Property in Sec. S \_\_\_\_\_ T \_\_\_\_\_ R \_\_\_\_\_  
 S \_\_\_\_\_ T \_\_\_\_\_ R \_\_\_\_\_


REG. OF DEEDS  
 97 OCT 15 AM 8:50  
 STATE OF MICHIGAN  
 COUNTY OF KENT  
 RECEIVED FOR RECORD

**10183**

Register of Deeds Stamp & File Number

4. Lot No. \_\_\_\_\_, Recorded Plat \_\_\_\_\_  
 5. Private Claims \_\_\_\_\_

I, Randy Kolehouse, in a field survey on January 23 19 97, do hereby certify that under requirements of P.A. 74 Michigan P.A. of 1970, the corner points mentioned in lines 1 and 2 above were in conformance with regulations and rules therefore as required in the current manual of survey instructions of the United States Department of the Interior, Bureau of Land Management or by a decree of a Court of Law and/or that the corner points mentioned in lines 3, 4 and 5 above were in conformance with the rules of the Michigan Board of Land Surveyors or by a Decree of a Court of Law; established, re-established, monumented, re-monumented, recovered, found as expressed below:

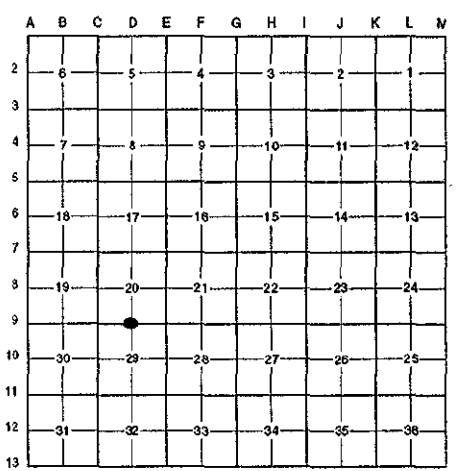

**NOTE: Not more than 4 corners, all in the same town and range, may be recorded on this certificate.**

A. Description of original monument and accessories and/or subsequent restoration:

D-9	1831	G.L.O. Notes	Mullett	Set Post
	N/A	Witness Map	K.C. Surveyor	Iron
	1935	Notes	Williams & Works	N/A
	1980	L.C.R.C. #2352	Exxel Engineering	Set Capped Re-Rod
	1981	L.C.R.C. #2500	Williams & Works	Capped Rebar
	1982	L.C.R.C. #2970	Williams & Works	Fnd. Capped Re-rod / Set K.C. Monument
	1989	L.C.R.C. #5123	T. Chettleburgh	K.C. Monument


This corner was originally approved by the Kent County Remonumentation Peer Group and monumented by Williams & Works on 5/27/82 and was recorded per L.C.R.C. #2970.

B. Description of corner evidence found and/or method applied in restoring or reestablishing corner:  
 D-9 Found a Standard Kent County Monument 29' South of a pasture fence running East and West and 570' East of the woods running North and South per L.C.R.C.'s #2970 and #5123 as set by Williams & Works in place of a capped re-rod they found which checked L.C.R.C.'s #2500, #2352 and the K.C. Surveyor's records.

L.C.R.C. #2970	L.C.R.C. #5123
Nail & K.C. Remon. tag in N side 30" Oak N 87° W 568.80'	Top Centerline red topped "T" Steel Fence Post N 53° E 39.04
Nail & K.C. Remon. tag in SW corner pole barn S 85° E 501.83'	K.C. Remon. Tag & Nail Southwest Corner Pole Shed S 81° E 501.61' (m. 501.52')
Nail & K.C. Remon. tag in W side 12" Maple S 10° E 426.0'	K.C. Remon. Tag & Nail West side 17" Maple S 01° E 425.84' (m. 425.81')
Top centerline red topped "T" fence post N 40° E 38.86'	K.C. Remon. Tag & Nail North side 28" Oak N 82° W 568.76' (m. 568.68')

The selected location is accepted by me and is generally accepted by professional surveyors as the best available evidence of the position of the original corner.

C. Description of monument for corner and accessories established to perpetuate locating the position of the corner:  
 D-9 Standard Kent County Monument  
 Nail & K.C. remon. tag on S side post at SW corner pole shed S 81° E 501.52'  
 Nail & K.C. remon. tag on N side 28" Oak N 82° W 568.68'  
 Nail & K.C. remon. tag on W side 18" Maple S 01° E 425.81'  
 Top center line steel fence post N 53° E 39.04'

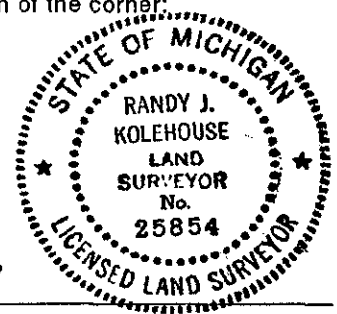

Signed by Randy J. Kolehouse Date 8-1-97  
 EARTH TECH

Surveyor's Michigan License No. 25854

P.A. 345 1990 KENT COUNTY  
 PEER APPROVED 5/22/97  
 CHAIRMAN Harry Huber