

SURVEY & REMONUMENTATION

MAR 03 1998

LAND CORNER RECORDATION CERTIFICATE

Filing Requirement of Act 74, Mich. P.A. 1970

KENT COUNTY REMONUMENTATION

SECTION

For corners in

Kent (County)	Located in:	Ada Township	Corner Code #
1. Public Land Survey	T <u>7N</u> R <u>10W</u>		<u>E-1</u>
	T _____ R _____		_____
	T _____ R _____		_____
	T _____ R _____		_____
2. Property Controlling in Section	S _____ T _____ R _____		_____
	S _____ T _____ R _____		_____
3. Miscellaneous Property in Sec.	S _____ T _____ R _____		_____
	S _____ T _____ R _____		_____

10185

REG. OF DEEDS

Lucy Spauld


97 OCT 15 AM 8:50

STATE OF MICHIGAN
COUNTY OF KENT
RECEIVED FOR RECORD

Register of Deeds Stamp & File Number

4. Lot No. _____, Recorded Plat _____
5. Private Claims _____

I, Randy Kolehouse, in a field survey on April 10 19 97, do hereby certify that under requirements of P.A. 74 Michigan P.A. of 1970, the corner points mentioned in lines 1 and 2 above were in conformance with regulations and rules therefore as required in the current manual of survey instructions of the United States Department of the Interior, Bureau of Land Management or by a decree of a Court of Law and/or that the corner points mentioned in lines 3, 4 and 5 above were in conformance with the rules of the Michigan Board of Land Surveyors or by a Decree of a Court of Law; established, re-established, monumented, re-monumented, recovered, found as expressed below:

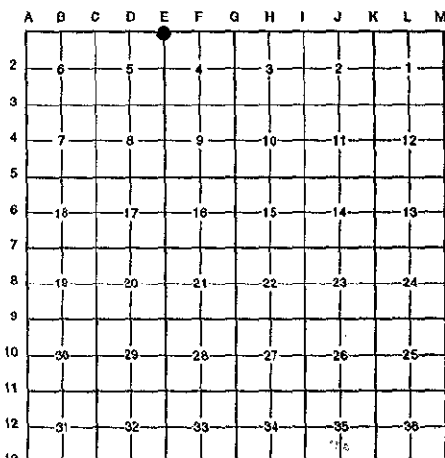

NOTE: Not more than 4 corners, all in the same town and range, may be recorded on this certificate.

A. Description of original monument and accessories and/or subsequent restoration:

Date	Description	Surveyor/Engineer	Monument
1831	G.L.O. Notes	Mullett	Set Post
1964	Witness Map	K.C. Surveyor	Iron & Stone
1964	Notes	Williams & Works	Iron & Stone
1972	Notes	Exxel Engineering	N/A
1974	L.C.R.C. #727	Medema, Van Kooten & Assoc.	1-1/2" Square Iron
1984	L.C.R.C. #3958	Exxel Engineering	Fnd. 1" Pipe / Set K.C. Monument
1992	L.C.R.C. #6263	Chris Marschall	K.C. Monument

P.A. 345 1990 KENT COUNTY

PEER APPROVED 5/22/97
CHAIRMAN Harry Huber

Note: This corner is not common with E-13, T8N, R10W.

This corner was originally approved by the Kent County Remonumentation Peer Group and monumented by Exxel Engineering on 9/14/84 and was recorded per L.C.R.C. #3958.

B. Description of corner evidence found and/or method applied in restoring or reestablishing corner:

E-1 Found a Standard Kent County Monument on the Township line at the C/L of Egypt Valley (bit.) running South and 10' North of the C/L of 4 Mile Road (gravel) running East and West per L.C.R.C.'s #3958 and #6263 as set by Exxel Engineering in place of a 1" pipe they found in clay 2' below grade which checked L.C.R.C. #727, the notes of Williams & Works and Exxel Engineering, and the K.C. Surveyor's records.

L.C.R.C. #3958

L.C.R.C. #6263

Nail & remon tag in SE sde 12" Hickory N 55° E 79.34'
Nail & remon tag in SE sde P. Pole S 43° W 119.76'
Monument is on line with C/L bituminous road to South
C/L E-W gravel road South 10' ±
C/L gravel road to North East 150' ±

Nail & tag NE sd. P.P. N 41 W 34.09'
Nail & tag NW sd. 36" Hickory N 64 E 62.45'
Nail & tag SE sd. 18" Hickory N 52 E 79.29'
Nail & tag SE sd. P.P. (5' above grd.) S 38 W 119.75'
On line with Bit. Rd. to South
More or less 10' N of C/L of Bit. Rd. E & W
C/L Bit. road to North (1/2" Rebar in Conc) N 90° E 150.02'


The selected location is accepted by me and is generally accepted by professional surveyors as the best available evidence of the position of the original corner.

C. Description of monument for corner and accessories established to perpetuate locating the position of the corner:

E-1 Standard Kent County Monument

Nail & K.C. remon. tag on NE side P. pole N 41° W 34.12'
Nail & K.C. remon. tag on NW side 36" Hickory N 64° E 62.51'
Nail & K.C. remon. tag on SE side 18" Hickory N 52° E 79.41'
Nail & K.C. remon. tag on SE side P. pole S 38° W 119.85'

K.C. Mon., E-13, T8N, R10W, East 264.02'
" + " cut South end 12" CMP S 50° E 77.88'
Rebar East 150.02'

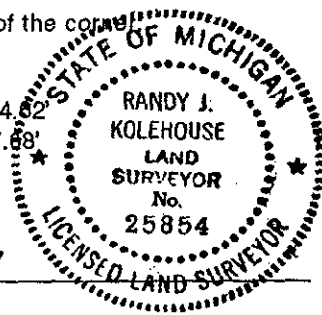

Signed by Randy J. Kolehouse

Date 8-1-97

Surveyor's Michigan License No. 25854