

SURVEY & REMONUMENTATION

MAR 03 1998

SECTION

LAND CORNER RECORDATION CERTIFICATE
Filing Requirement of Act 74, Mich. P.A. 1970
KENT COUNTY REMONUMENTATION

For corners in

Kent (County)	Located in:	Ada Township	Corner Code #
1. Public Land Survey	T <u>7N</u>	R <u>10W</u>	<u>E-3</u>
	T _____	R _____	_____
	T _____	R _____	_____
	T _____	R _____	_____
2. Property Controlling in Section	S _____	T _____	R _____
	S _____	T _____	R _____
3. Miscellaneous Property in Sec.	S _____	T _____	R _____
	S _____	T _____	R _____

REG. OF DEEDS

Tim Stoddard

97 OCT 15 AM 8:50


STATE OF MICHIGAN
 COUNTY OF KENT
 RECEIVED FOR RECORD

10187

Register of Deeds Stamp & File Number

4. Lot No. _____, Recorded Plat _____
 5. Private Claims _____

I, Randy Kolehouse, in a field survey on April 10 19 97, do hereby certify that under requirements of P.A. 74 Michigan P.A. of 1970, the corner points mentioned in lines 1 and 2 above were in conformance with regulations and rules therefore as required in the current manual of survey instructions of the United States Department of the interior, Bureau of Land Management or by a decree of a Court of Law and/or that the corner points mentioned in lines 3, 4 and 5 above were in conformance with the rules of the Michigan Board of Land Surveyors or by a Decree of a Court of Law; established, re-established, monumented, re-monumented, recovered, found as expressed below:

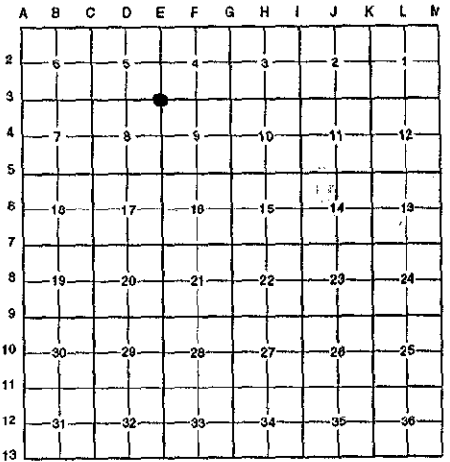

NOTE: Not more than 4 corners, all in the same town and range, may be recorded on this certificate.

A. Description of original monument and accessories and/or subsequent restoration:

E-3	1831	G.L.O. Notes	Mullett	Set Post	P.A. 345 1990 KENT COUNTY
	1935	Witness Map	K.C. Surveyor	Concrete Monument	PEER APPROVED <u>5/22/97</u>
	1971	L.C.R.C. #61	Williams & Works	Boat Spike Over Conc. Mon.	CHAIRMAN <u>Randy Kolehouse</u>
	1973	L.C.R.C. #551	P. Van Kooten	Boat Spike	
	1981	L.C.R.C. #2578	Jonker Land Survey	Fnd. 1/2" iron in Mon. Box / Set K.C. Monument in Mon. Box	
	1989	L.C.R.C. #5127	T. Chettleburgh	K.C. Monument in Monument Box	

This corner was originally approved by the Kent County Remonumentation Peer Group and monumented by Rob Jonker on 12/21/81 and was recorded per L.C.R.C. #2578.

B. Description of corner evidence found and/or method applied in restoring or reestablishing corner:

E-3 Found a Standard Kent County Monument at the C/L intersection of Egypt Valley Avenue (bit.) running North and South and 3 Mile Road (gravel) running East and West per L.C.R.C.'s #2578 and #5127 as set by Rob Jonker in place of a 1/2" iron he found at grade in a monument box over a spike 14" below grade and over a 1" iron 18" below grade which checked L.C.R.C.'s #551, #61 and the K.C. Surveyor's records.

L.C.R.C. #2578

L.C.R.C. #5127

Remon. tag on NW side 20" Walnut S 21° W 91.70'
 "X" on top H/W N 69° W 48.37'
 "X" on top H/W S 72° W 48.50'
 "X" on top H/W N 73° E 59.81'
 On C/L "X" pavement


K.C. Remon. Tag & Nail North side 20" Hickory S 76° E 142.95' (m. 143.04')
 K.C. Remon. Tag & Nail East side 24" Oak S 20° W 91.96' (m. 91.99')
 Chiseled "X" East End, Top Concrete Headwall N 71° W 48.38'
 Chiseled "X" East End, Top Concrete Headwall S 72° W 48.47' (m. 48.50')
 Chiseled "X" Top Concrete Headwall N 74° E 59.79' (m. 59.86')

The selected location is accepted by me and is generally accepted by professional surveyors as the best available evidence of the position of the original corner.

C. Description of monument for corner and accessories established to perpetuate locating the position of the corner:

E-3 Standard Kent County Monument

Nail & K.C. remon. tag on N side 20" Hickory S 76° E 143.04'
 Nail & K.C. remon. tag on E side 24" Oak S 20° W 91.99'
 "X" cut in top of conc. headwall N 71° W 48.38'
 "X" cut in top of conc. headwall S 72° W 48.50'
 "X" cut in top of conc. headwall N 74° E 59.86'
 NE cor. base of N headwall WNW 46.53'

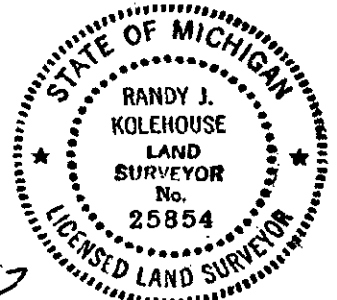

Signed by Randy J. Kolehouse Date 8-1-97

Surveyor's Michigan License No. 25854