

SURVEY & REMONUMENTATION

MAR 03 1998

SECTION

LAND CORNER RECORDATION CERTIFICATE
Filing Requirement of Act 74, Mich. P.A. 1970
KENT COUNTY REMONUMENTATION

For corners in

	<u>Kent</u> (County)	Located in:	Ada Township	Corner Code #
1. Public Land Survey		T <u>7N</u>	R <u>10W</u>	<u>E-4</u>
		T _____	R _____	_____
		T _____	R _____	_____
		T _____	R _____	_____
2. Property Controlling in Section	S _____	T _____	R _____	_____
	S _____	T _____	R _____	_____
3. Miscellaneous Property in Sec.	S _____	T _____	R _____	_____
	S _____	T _____	R _____	_____


REG. OF DEEDS
 STATE OF MICHIGAN
 COUNTY OF KENT
 RECEIVED FOR RECORD
 97 OCT 15 AM 8:50
David J. Kule

10188

Register of Deeds Stamp & File Number

4. Lot No. _____, Recorded Plat _____
 5. Private Claims _____

I, Randy Kolehouse, in a field survey on April 10 19 97, do hereby certify that under requirements of P.A. 74 Michigan P.A. of 1970, the corner points mentioned in lines 1 and 2 above were in conformance with regulations and rules therefore as required in the current manual of survey instructions of the United States Department of the interior, Bureau of Land Management or by a decree of a Court of Law and/or that the corner points mentioned in lines 3, 4 and 5 above were in conformance with the rules of the Michigan Board of Land Surveyors or by a Decree of a Court of Law; established, re-established, monumented, re-monumented, recovered, found as expressed below:

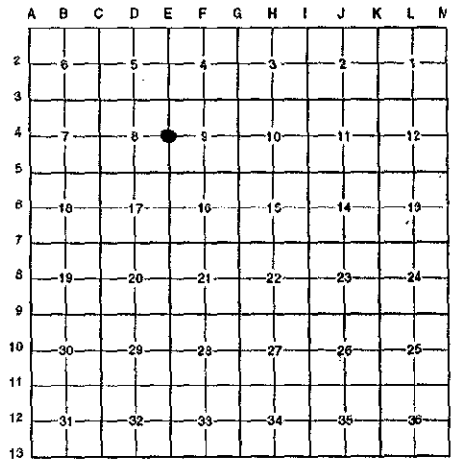

NOTE: Not more than 4 corners, all in the same town and range, may be recorded on this certificate.

A. Description of original monument and accessories and/or subsequent restoration:

E-4	1831	G.L.O. Notes	Mullett	Set Post
	1960	Witness Map	K.C. Surveyor	1" Iron
	1973	L.C.R.C. #517	Exxel Engineering	Boat Spike
	1982	L.C.R.C. #3318	Moore & Bruggink	Fnd. Boat Spike / Set K.C. Monument Over Stone
	1989	L.C.R.C. #5128	T. Chettleburgh	K.C. Monument

P.A. 345 1990 KENT COUNTY
 PEER APPROVED 5/22/97
 CHAIRMAN *Randy Kolehouse*

This corner was originally approved by the Kent County Remonumentation Peer Group and monumented by Moore & Bruggink on 5/18/82 and was recorded per L.C.R.C. #3318.

B. Description of corner evidence found and/or method applied in restoring or reestablishing corner:

E-4 Found a Standard Kent County Monument at the C/L intersection of Egypt Valley Avenue (bit.) running North and South and Knapp Street (bit.) running East and West per L.C.R.C.'s #3318 and #5128 as set by Moore & Bruggink in place of a boat spike they found over a 1" iron over stone which checked L.C.R.C. #517 and the K.C. Surveyor's records.

L.C.R.C. #3318

K.C. Tag & Nail in 32" Oak S 35° E 58.23'
 K.C. Tag & Nail in 30" Oak N 30° E 74.30'
 SE Cor. 7' x 15' Conc. Platform at SE Cor. of Stone
 N 40° W 80.82'

L.C.R.C. #5128


K.C. Remon. Tag & Nail East side 25" Oak N 30° E 74.32' (m. 74.35')
 K.C. Remon. Tag & Nail West side 32" Oak S 30° E 58.22'
 Southeast Corner 7' x 15' Concrete Platform at Ground Line
 N 50° W 80.84' (80.89')

The selected location is accepted by me and is generally accepted by professional surveyors as the best available evidence of the position of the original corner.

C. Description of monument for corner and accessories established to perpetuate locating the position of the corner:

E-4 Standard Kent County Monument

Nail & K.C. remon. tag on E side 26" Oak N 30° E 74.35'
 Nail & K.C. remon. tag on W side 32" Oak S 30° E 58.22'
 SE cor. conc. stoop @ ground level N 50° W 80.89'
 Nail & K.C. remon. tag on W side P. pole S 40° W 57.48'

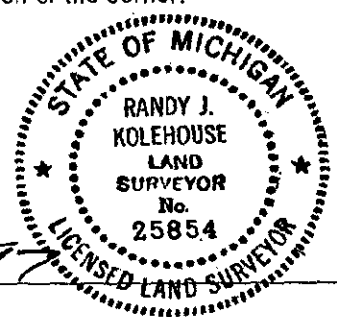

Signed by *Randy J. Kolehouse* Date 8-1-97
 EARTH TECH

Surveyor's Michigan License No. 25854