

SURVEY & REMONUMENTATION

MAR 03 1998

LAND CORNER RECORDATION CERTIFICATE Filing Requirement of Act 74, Mich. P.A. 1970 KENT COUNTY REMONUMENTATION

For corners in SECTION

<u>Kent</u> (County)	Located in: <u>Ada</u> Township	Corner Code # <u>E-5</u>	
1. Public Land Survey	T <u>7N</u> R <u>10W</u>	<u>E-5</u>	
	T _____ R _____	_____	
	T _____ R _____	_____	
	T _____ R _____	_____	
2. Property Controlling In Section	S _____ T _____ R _____	_____	
	S _____ T _____ R _____	_____	
3. Miscellaneous Property in Sec.	S _____ T _____ R _____	_____	
	S _____ T _____ R _____	_____	

10189

Register of Deeds Stamp & File Number

STATE OF MICHIGAN
COUNTY OF KENT
RECEIVED FOR RECORD


97 OCT 15 AM 8:50

REG. OF DEEDS

Lucy Bond

4. Lot No. _____, Recorded Plat _____
5. Private Claims _____

I, Randy Kolehouse, in a field survey on April 1 19 97, do hereby certify that under requirements of P.A. 74 Michigan P.A. of 1970, the corner points mentioned in lines 1 and 2 above were in conformance with regulations and rules therefore as required in the current manual of survey instructions of the United States Department of the interior, Bureau of Land Management or by a decree of a Court of Law and/or that the corner points mentioned in lines 3, 4 and 5 above were in conformance with the rules of the Michigan Board of Land Surveyors or by a Decree of a Court of Law; established, re-established, monumented, re-monumented, recovered, found as expressed below:

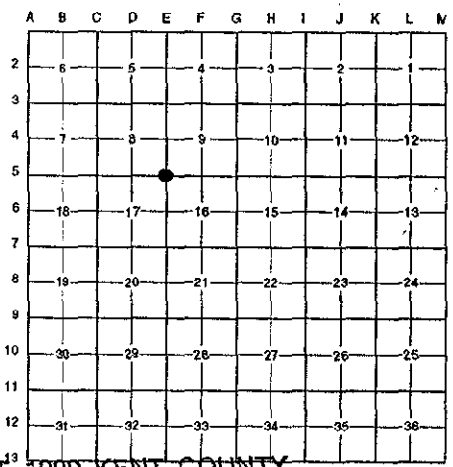

NOTE: Not more than 4 corners, all in the same town and range, may be recorded on this certificate.

A. Description of original monument and accessories and/or subsequent restoration:				P.A. 345 ³ 1990 KENT COUNTY.
E-5	1831 G.L.O. Notes	Mullet	Set Post	PEER APPROVED <u>5/22/97</u> CHAIRMAN <u>Harry Hubert</u>
	1947 Witness Map	K.C. Surveyor	Stone	
	1973 L.C.R.C. #517	Exxel Engineering	1" Iron	
	1982 L.C.R.C. #3150	Moore & Bruggink	Fnd. 1-1/4" Iron Over Stone / Set K.C. Monument	
	1989 L.C.R.C. #5129	T. Chettleburgh	K.C. Monument	

This corner was originally approved by the Kent County Remonumentation Peer Group and monumented by Moore & Bruggink on 6/18/82 and was recorded per L.C.R.C. #3150.

- B. Description of corner evidence found and/or method applied in restoring or reestablishing corner:
- E-5 Found a Standard Kent County Monument 1.2' below grade at the C/L intersection of 2 Mile Road (gravel) running East and West and Egypt Valley Avenue (gravel) running North and South per L.C.R.C.'s #3150 and #5129 as set by Moore & Bruggink in place of a 1-1/4" iron they found over a 7" x 18" pyramid shaped stone which checked L.C.R.C. #517 and the K.C. Surveyor's records.

<p style="text-align: center;">L.C.R.C. #3150</p> <p>K.C. Nail & Tag 48" Oak S 40° W 62.46'</p> <p>K.C. Nail & Tag 12" Walnut N 40° W 53.68'</p> <p>K.C. Nail & Tag 14" Walnut N 20° W 90.06'</p> <p>K.C. Nail & Tag 48" Ash N 70° E 110.85'</p>	<p style="text-align: center;">L.C.R.C. #5129</p> <p>K.C. Remon. Tag & Nail South side 48" Ash N 74° E 110.85' (m. 110.94')</p> <p>K.C. Remon. Tag & Nail Southwest side 8" Elm stump S 48° E 52.59' (m. 52.71')</p> <p>K.C. Remon. Tag & Nail East side 40" Oak S 50° W 62.47' (m. 62.49')</p> <p>K.C. Remon. Tag & Nail Northeast side 15" Walnut N 30° W 53.69' (m. 53.72')</p> <p>K.C. Remon. Tag & Nail East side 20" Walnut N 10° W 90.08' (m. 90.11')</p>
--	--

The selected location is accepted by me and is generally accepted by professional surveyors as the best available evidence of the position of the original corner.

- C. Description of monument for corner and accessories established to perpetuate locating the position of the corner:
- E-5 Standard Kent County Monument
- Nail & K.C. remon. tag on S side 48" Ash N 74° E 110.94'
 - Nail & K.C. remon. tag on SW side 8" Elm stump S 48° E 52.71'
 - Nail & K.C. remon. tag on E side 40" Oak S 50° W 62.49'
 - Nail & K.C. remon. tag on NE side 16" Walnut N 30° W 53.72'
 - Nail & K.C. remon. tag on E side 20" Walnut N 10° W 90.11'



Signed by *Randy J. Kolehouse* Date *8/1-97*
EARTH TECH

Surveyor's Michigan License No. 25854