

SURVEY & REMONUMENTATION

MAR 03 1998

LAND CORNER RECORDATION CERTIFICATE
Filing Requirement of Act 74, Mich. P.A. 1970
KENT COUNTY REMONUMENTATION

STATE OF MICHIGAN
 COUNTY OF KENT
 RECEIVED FOR RECORD
 97 OCT 15 AM 8:50
 REG. OF DEEDS
David J. ...

SECTION

For corners in

Kent
 (County)

Located in: Ada
 Township

Corner Code #

- | | | | |
|------------------------------------|-------------|--------------|------------|
| 1. Public Land Survey | T <u>7N</u> | R <u>10W</u> | <u>E-8</u> |
| | T _____ | R _____ | _____ |
| | T _____ | R _____ | _____ |
| | T _____ | R _____ | _____ |
| 2. Property Controlling in Section | S _____ | T _____ | R _____ |
| | S _____ | T _____ | R _____ |
| 3. Miscellaneous Property in Sec. | S _____ | T _____ | R _____ |
| | S _____ | T _____ | R _____ |

10192

Register of Deeds Stamp & File Number

4. Lot No. _____, Recorded Plat _____
 5. Private Claims _____

I, Randy Kolehouse, in a field survey on January 30 19 97, do hereby certify that under requirements of P.A. 74 Michigan P.A. of 1970, the corner points mentioned in lines 1 and 2 above were in conformance with regulations and rules therefore as required in the current manual of survey instructions of the United States Department of the interior, Bureau of Land Management or by a decree of a Court of Law and/or that the corner points mentioned in lines 3, 4 and 5 above were in conformance with the rules of the Michigan Board of Land Surveyors or by a Decree of a Court of Law; established, re-established, monumented, re-monumented, recovered, found as expressed below:

A	B	C	D	E	F	G	H	I	J	K	L	M
2	8	5	4	3	2	1						
3												
4	7	3	9	10	11	12						
5												
6	18	17	16	15	14	13						
7												
8	19	20	21	22	23	24						
9												
10	30	29	28	27	26	25						
11												
12	31	32	33	34	35	36						
13												

NOTE: Not more than 4 corners, all in the same town and range, may be recorded on this certificate.

A. Description of original monument and accessories and/or subsequent restoration:

E-8	1831	G.L.O. Notes	Mullett	Set Post
	1956	Witness Map	K.C. Surveyor	N/A
	1982	L.C.R.C. #3147	Moore & Bruggink	Fnd. Concrete Monument / Set K.C. Monument
	1989	L.C.R.C. #5132	T. Chettleburgh	K.C. Monument

P.A. 345 1990 KENT COUNTY
 PEER APPROVED 5/22/97
 CHAIRMAN Randy Kolehouse

This corner was originally approved by the Kent County Remonumentation Peer Group and monumented by Moore & Bruggink on 8/2/82 and was recorded per L.C.R.C. #3147.

B. Description of corner evidence found and/or method applied in restoring or reestablishing corner:

E-8 Found a Standard Kent County Monument 220' ± South of the C/L of Pettis Avenue (bit.) running Northeast and Southwest in a tree row running North and South per L.C.R.C.'s #3147 and #5132 as set by Moore & Bruggink in place of a concrete monument they found which checked the K.C. Surveyor's records.

L.C.R.C. #3147

L.C.R.C. #5132

K.C. Nail & Tag 8" Hickory S 20° E 33.50'
 K.C. Nail & Tag 5" Elm N 85° W 50.48'
 K.C. Nail & Tag 40" Oak N 05° E 6.29'


K. C. Remon. Tag & Nail West side 40" Oak N 35° E 6.29'
 K. C. Remon. Tag & Nail East side 9" Hickory S 19° E 33.46'
 K. C. Remon. Tag & Nail North side Tw. 5" Elm N 74° W 50.40'

The selected location is accepted by me and is generally accepted by professional surveyors as the best available evidence of the position of the original corner.

C. Description of monument for corner and accessories established to perpetuate locating the position of the corner:

E-8 Standard Kent County Monument

Nail & K.C. remon. tag on W side 42" Oak N 35° E 6.29'
 Nail & K.C. remon. tag on E side 9" Hickory S 19° E 33.46'
 Nail & K.C. remon. tag on N side Twin 5" Elm N 75° W 50.40'
 Nail & K.C. remon. tag on W side 12" Ash S 15° W 31.45'

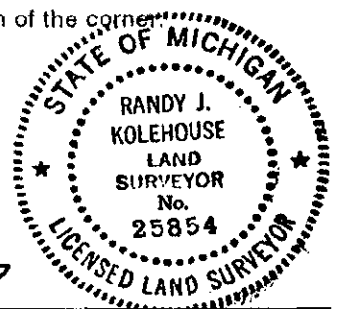

Signed by Randy J. Kolehouse Date 8-1-97
 EARTH TECH

Surveyor's Michigan License No. 25854