

**SURVEY & REMONUMENTATION**

MAR 03 1998

**SECTION**

**LAND CORNER RECORDATION CERTIFICATE**  
**Filing Requirement of Act 74, Mich. P.A. 1970**  
**KENT COUNTY REMONUMENTATION**

For corners in

Kent (County)	Located in:	Ada Township	Corner Code #
1. Public Land Survey	T <u>7N</u>	R <u>10W</u>	<u>E-10</u>
	T _____	R _____	_____
	T _____	R _____	_____
	T _____	R _____	_____
2. Property Controlling in Section	S _____	T _____	R _____
	S _____	T _____	R _____
3. Miscellaneous Property in Sec.	S _____	T _____	R _____
	S _____	T _____	R _____

REG. OF DEEDS

*Lucy Bond*

97 OCT 15 AM 8:50

STATE OF MICHIGAN  
 COUNTY OF KENT  
 RECEIVED FOR RECORD

10193

Register of Deeds Stamp & File Number

4. Lot No. \_\_\_\_\_, Recorded Plat \_\_\_\_\_  
 5. Private Claims \_\_\_\_\_


I, Randy Kolehouse, in a field survey on January 24 19 97, do hereby certify that under requirements of P.A. 74 Michigan P.A. of 1970, the corner points mentioned in lines 1 and 2 above were in conformance with regulations and rules therefore as required in the current manual of survey instructions of the United States Department of the interior, Bureau of Land Management or by a decree of a Court of Law and/or that the corner points mentioned in lines 3, 4 and 5 above were in conformance with the rules of the Michigan Board of Land Surveyors or by a Decree of a Court of Law; established, re-established, monumented, re-monumented, recovered, found as expressed below:

**NOTE: Not more than 4 corners, all in the same town and range, may be recorded on this certificate.**

**A. Description of original monument and accessories and/or subsequent restoration:**

E-10	1831	G.L.O. Notes	Mullett	Set Post
	N/A	Witness Map	K.C. Surveyor	Iron
	1971	L.C.R.C. #14	J. Spencer	3/4" Pipe & Stones
	1971	L.C.R.C. #101	Williams & Works	Iron & Stones
	1980	L.C.R.C. #1496	Williams & Works	Fnd. 3/4" Pipe in Stones / Set K.C. Monument
	1989	L.C.R.C. #5133	T. Chettleburgh	K.C. Monument

P.A. 345 1990 KENT COUNTY  
 PEER APPROVED 5/22/97  
 CHAIRMAN Randy Kolehouse

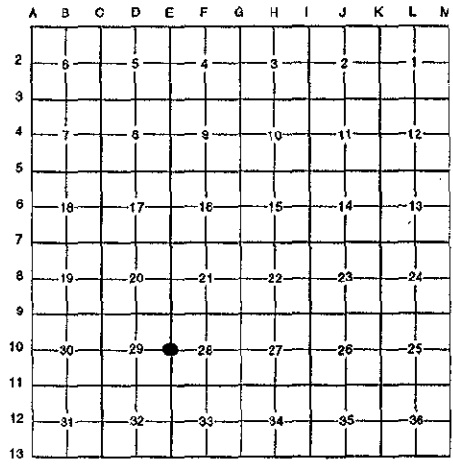

This corner was originally approved by the Kent County Remonumentation Peer Group and monumented by Williams & Works on 12/5/80 and was recorded per L.C.R.C. #1496.

**B. Description of corner evidence found and/or method applied in restoring or reestablishing corner:**

E-10 Found a Standard Kent County Monument on the South edge of the woods per L.C.R.C.'s #1496 and #5133 as set by Williams & Works in place of a 3/4" pipe they found surrounded by stones which checks L.C.R.C.'s #101, #14 and the K.C. Surveyor's records.

**L.C.R.C. #1496**

- Nail & K.C. Remon. Tag South Side 14" Oak S 85° W 22.33'
- Nail & K.C. Remon. Tag N'y Side 10" Pine N 60° W 32.92'
- Nail & K.C. Remon. Tag S'y Side 10" Oak N 60° E 6.93'
- Nail & K.C. Remon. Tag NE'y Side 4" Sass. N 10° W 21.03'

**L.C.R.C. #5133**


- K.C. Remon. Tag & Nail West side 20" Oak N 18° E 34.00'
- K.C. Remon. Tag & Nail Southeast side Tw. 9" Oak N 35° E 19.64'
- K.C. Remon. Tag & Nail South side 9" Oak N 62° E 6.92'
- K.C. Remon. Tag & Nail South side 13" Oak N 82° W 22.33'
- K.C. Remon. Tag & Nail North side 9" Pine N 59° W 32.90'
- K.C. Remon. Tag & Nail Northeast side 5" Sassafra N 08° W 21.09' (m. 21.15')

The selected location is accepted by me and is generally accepted by professional surveyors as the best available evidence of the position of the original corner.

**C. Description of monument for corner and accessories established to perpetuate locating the position of the corner:**

**E-10 Standard Kent County Monument**

- Nail & K.C. remon. tag on W side 20" Oak N 18° E 34.00'
- Nail & K.C. remon. tag on SE side Twin 9" Oak N 35° E 19.64'
- Nail & K.C. remon. tag on S side 12" Oak N 62° E 6.92'
- Nail & K.C. remon. tag on S side 15" Oak N 82° W 22.33'
- Nail & K.C. remon. tag on N side 12" Pine N 55° W 32.90'
- Nail & K.C. remon. tag on NE side 6" Sassafra N 08° W 21.15'

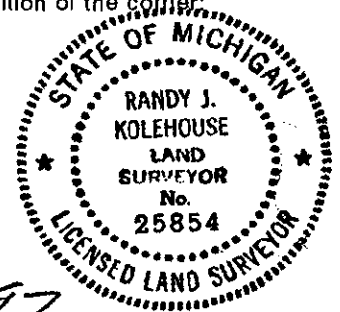

Signed by Randy J. Kolehouse Date 8-1-97  
 EARTH TECH

Surveyor's Michigan License No. 25854