

SURVEY & REMONUMENTATION

MAR 03 1998

SECTION

LAND CORNER RECORDATION CERTIFICATE
Filing Requirement of Act 74, Mich. P.A. 1970
KENT COUNTY REMONUMENTATION

For corners in

<u>Kent</u> (County)	Located in:	Ada Township	Corner Code #
1. Public Land Survey	T <u>7N</u> R <u>10W</u>		<u>E-11</u>
	T _____ R _____		_____
	T _____ R _____		_____
	T _____ R _____		_____
2. Property Controlling in Section	S _____ T _____ R _____		_____
	S _____ T _____ R _____		_____
3. Miscellaneous Property in Sec.	S _____ T _____ R _____		_____
	S _____ T _____ R _____		_____

REG. OF DEEDS

Luis J. Kohn

97 OCT 15 AM 8:50

STATE OF MICHIGAN
 COUNTY OF KENT
 RECEIVED FOR RECORD

10194

Register of Deeds Stamp & File Number

4. Lot No. _____, Recorded Plat _____
 5. Private Claims _____

I, Randy Kolehose, in a field survey on January 24 19 97, do hereby certify that under requirements of P.A. 74 Michigan P.A. of 1970, the corner points mentioned in lines 1 and 2 above were in conformance with regulations and rules therefore as required in the current manual of survey instructions of the United States Department of the interior, Bureau of Land Management or by a decree of a Court of Law and/or that the corner points mentioned in lines 3, 4 and 5 above were in conformance with the rules of the Michigan Board of Land Surveyors or by a Decree of a Court of Law; established, re-established, monumented, re-monumented, recovered, found as expressed below:

NOTE: Not more than 4 corners, all in the same town and range, may be recorded on this certificate.


A. Description of original monument and accessories and/or subsequent restoration:

E-11	1831	G.L.O. Notes	Mullett	Set Post
	1963	Witness Map	K.C. Surveyor	Iron
	1971	L.C.R.C. #15	J. Spencer	3/4" Pipe in Stones
	1971	L.C.R.C. #101	Williams & Works	Iron
	1980	L.C.R.C. #1491	Williams & Works	Fnd. 3/4" Iron & Stones / Set K.C. Monument
	1989	L.C.R.C. #5134	T. Chettleburgh	K.C. Monument

P.A. 345 1990 KENT COUNTY

PEER APPROVED 5/22/97

CHAIRMAN Randy Kolehose

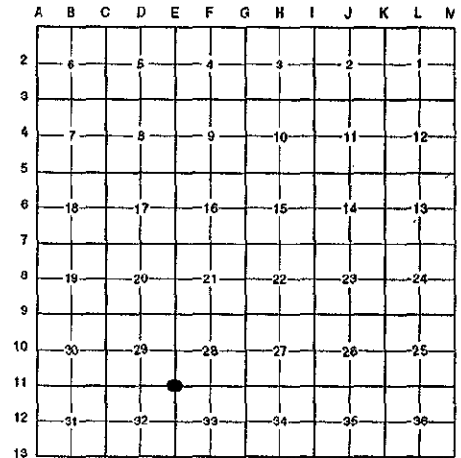

This corner was originally approved by the Kent County Remonumentation Peer Group and monumented by Williams & Works on 12/3/80 and was recorded per L.C.R.C. #1491.

B. Description of corner evidence found and/or method applied in restoring or reestablishing corner:

E-11 Found a Standard Kent County Monument on the side lot line between houses #6386 and #6400 in Lehigh Court per L.C.R.C.'s #1491 and #5134 as set by Williams & Works in place of a 3/4" iron and stones they found which checked L.C.R.C.'s #101, #15 and the K.C. Surveyor's records.

L.C.R.C. #1491

Nail & K.C. Remon. Tag N'y Side 4" Cedar S 60° W 15.85'
 Nail & K.C. Remon. Tag W'y Side 12" Oak S 46° E 53.08'
 Power Line South 100'± Cor. on East-West Fence

L.C.R.C. #5134

K.C. Remon. Tag & Nail West side 15" Oak S 47° E 53.08' (m. 53.12')
 Power Line South 110'±
 K.C. Remon. Tag & Nail Southeast side 14" Oak S 48° W 28.95'
 K.C. Remon. Tag & Nail North side 4" Cedar S 60° W 15.83' (m. 15.87')
 K.C. Remon. Tag & Nail East side Tw. 11" Maple N 15° W 31.89' (m. 31.92')

The selected location is accepted by me and is generally accepted by professional surveyors as the best available evidence of the position of the original corner.

C. Description of monument for corner and accessories established to perpetuate locating the position of the corner:

E-11 Standard Kent County Monument

Nail & K.C. remon. tag on W side 15" Oak S 47° E 53.12'
 Nail & K.C. remon. tag on SE side 14" Oak S 48° W 28.95'
 Nail & K.C. remon. tag on N side 4" Cedar S 60° W 15.87'
 Nail & K.C. remon. tag on E side Twin 11" Maple N 15° W 31.92'

Signed by Randy J. Kolehose Date 2-1-97
 Surveyor's Michigan License No. 25854

