

SURVEY & REMONUMENTATION

MAR 03 1998

SECTION

LAND CORNER RECORDATION CERTIFICATE
Filing Requirement of Act 74, Mich. P.A. 1970
KENT COUNTY REMONUMENTATION

For corners in

Kent (County)

Located in: Ada Township

Corner Code #

- 1. Public Land Survey T 7N R 10W E-12
2. Property Controlling in Section S T R
3. Miscellaneous Property in Sec. S T R

- 4. Lot No. Recorded Plat
5. Private Claims

STATE OF MICHIGAN
COUNTY OF KENT
RECEIVED FOR RECORD
97 OCT 15 AM 8:50
REG. OF DEEDS

10195

Register of Deeds Stamp & File Number

I, Randy Kolehouse, in a field survey on January 24 19 97, do hereby certify that under requirements of P.A. 74 Michigan P.A. of 1970, the corner points mentioned in lines 1 and 2 above were in conformance with regulations and rules therefore as required in the current manual of survey instructions of the United States Department of the interior, Bureau of Land Management or by a decree of a Court of Law and/or that the corner points mentioned in lines 3, 4 and 5 above were in conformance with the rules of the Michigan Board of Land Surveyors or by a Decree of a Court of Law; established, re-established, monumented, re-monumented, recovered, found as expressed below:


NOTE: Not more than 4 corners, all in the same town and range, may be recorded on this certificate.

A. Description of original monument and accessories and/or subsequent restoration:

Table with 4 columns: Date (1831-1989), Description (G.L.O. Notes, Witness Map, L.C.R.C. #372, #592, #3148, #5135), Name (Mullet, K.C. Surveyor, Exxel Engineering, Moore & Bruggink, T. Chettleburgh), and Monument Type (Set Post, Stone & Iron, PK Nail / Set 1/2" Iron Pipe, 3/4" Iron, Fnd. 3/4" Iron / Set K.C. Monument, K.C. Monument).

P.A. 345 1990 KENT COUNTY

PEER APPROVED 5/22/97
CHAIRMAN Harry Huber

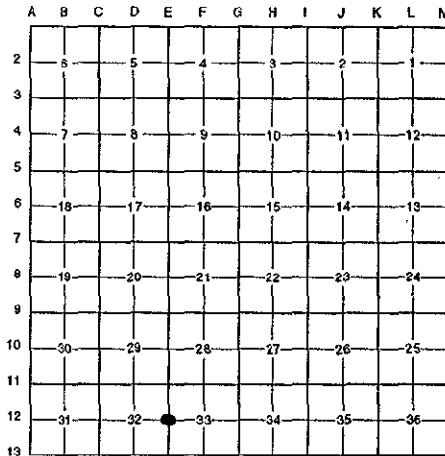

This corner was originally approved by the Kent County Remonumentation Peer Group and monumented by Moore & Bruggink on 6/21/82 and was recorded per L.C.R.C. #3148.

B. Description of corner evidence found and/or method applied in restoring or reestablishing corner:

E-12 Found a Standard Kent County Monument at the C/L intersection of Ada Road (bit.) running East and West and Colner Avenue (bit.) running South per L.C.R.C.'s #3148 and #5135 as set by Moore & Bruggink in place of a 1" iron they found over a 2-1/2" x 24" iron which checked L.C.R.C.'s #592, #372 and the K.C. Surveyor's records.

L.C.R.C. #3148

L.C.R.C. #5135

K.C. Nail & Tag in 11" Ash N 60° W 85.97'

Centerline MBT Manhole S 32° E 51.85'
K.C. Remon. Tag & Nail West side 17" Oak S 10° E 114.42'
K.C. Remon. Tag & Nail North side 38" Oak S 79° W 115.81'
K.C. Remon. Tag & Nail South side 18" Ash N 61° W 85.73'
Top Centerline Hydrant N 54° W 48.22'
K.C. Remon. Tag & Nail East side Telephone Pole N 16° W 34.24'

The selected location is accepted by me and is generally accepted by professional surveyors as the best available evidence of the position of the original corner.

C. Description of monument for corner and accessories established to perpetuate locating the position of the corner:

E-12 Standard Kent County Monument

Center line M.B.T. manhole S 32° E 51.85'
Nail & K.C. remon. tag on W side 18" Oak S 10° E 114.42'
Nail & K.C. remon. tag on N side 40" Oak S 79° W 115.81'
Top center line hyd. N 54° W 48.22'
Nail & K.C. remon. tag over old S side 20" Ash N 61° W 85.73'
Nail & K.C. remon. tag on E side T. pole N 16° W 34.24'

Signed by Randy J. Kolehouse Date 8-1-97

EARTH TECH

Surveyor's Michigan License No. 25854

