SURVEY & REMONUMENTATION

FEB 1 4 1997

COMMISSION

KENT COUNTY REMONUMENTATION

LAND CORNER RECORDATION CERTIFICATE

Filing Requirement of Act 74, Mich. P.A. 1970

STATE OF MICHIGAN
COUNTY OF KENT
RECEIVED FOR RECORD
96 JUN -7 AM 8:28
REG. OF DEEDS

9178

Register of Deeds Stamp & File Number

For corners in KENT COUNTY (County)

	Located In:	Corner Code #
1. Public Land Survey	T 7N R 10W	E-13
	T___ R___	
	T___ R___	
	T___ R___	
2. Property Controlling	S___ T___ R___	
in Section	S___ T___ R___	
3. Miscellaneous	S___ T___ R___	
Property in Sec.	S___ T___ R___	

4. Lot No. _____, Recorded Plat _____
5. Private Claims _____

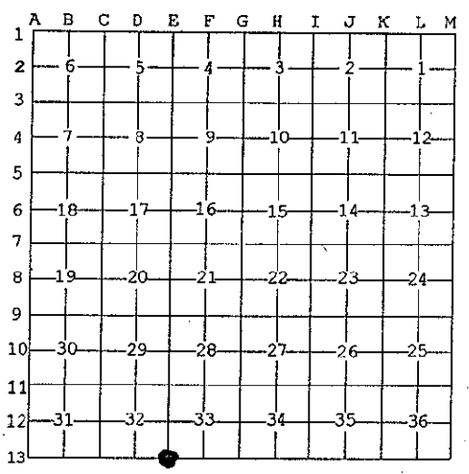

I, Kirk Breitels, in a field survey on Apr. 8, 19 96 do hereby state that under requirements of P.A. 74, Michigan P.A. of 1970, the corner points mentioned in lines 1 and 2 above were in conformance with regulations and rules therefore as required in the current manual of survey instructions of the United States Department of the Interior, Bureau of Land Management or by a decree of a Court of Law and /or that the corner points mentioned in lines 3, 4 and 5 above were in conformance with the rules of the Michigan Board of Land Surveyors or by a Decree of a Court of Law; established, re-established, monumented, recovered, found as expressed below:

NOTE: Not more than 2 corners, all in the same town and range, may be recorded on this certificate.

P.A. 345 1990 KENT COUNTY
PEER APPROVED 5/30/96
CHAIRMAN Harry Huber

A. Description of original monument and accessories and/or subsequent restoration:

E-13	1831	GLO	Mullett	Set Post
	1966	Kent Co. Wit.		Plow Point
	1981	LCRC #1545	Bonnema	Plow Point
	1982	LCRC #3141	Hackbardt	Set Kent County Monument
	1989	LCRC #5136	Chettleburgh	Set Kent Co. Mon. after const.
	1990	LCRC #5573	Bueche	Kent County Monument

The position of this corner was previously approved by the Kent County Remonumentation Peer Group, monumented by Glen S. Hackbardt on 8/30/82 and was recorded per LCRC #3141

B. Description of corner evidence found and/or method applied in restoring or reestablishing corner:

E-13 Found standard Kent Co. Mon. (Harrison) per witnesses from above LCRC as set by Thomas Chettleburgh at the same location as set in 1982 by Glen S. Hackbardt in place of the Plow Point he found. Said Plow Point checks with Kent Co. Wit. and LCRC #1545.

LCRC #5136 (Nail/tag in trees)
Tw. 13" Oak N36°E 86.98' 9" Oak N89°E 56.28'
16" Oak S39°E 101.47 11" Oak N63°W 81.55'
10" Oak N60°W 81.65' 10" Pine N40°W 61.58'
11" Pine N31°W 61.46'
KC Mon. E-1 6-10 West 70.55'

LCRC #5573
E. cor. brick pillar S70°W 29.80'
SE cor. brick pillar N75°W 22.85'
SW cor. brick pillar N35°W 25.64'
Angle pt. brk. pillar N20°W 37.60'
KC Mon. E-1, 6-10 West 70.55'

The selected location is accepted by me and is generally accepted by professional surveyors as the best available evidence of the position of the original corner.

C. Description of monument for corner and accessories established to perpetuate locating the position of the corner:

E-13 Standard Kent County Monument

E. corner brick pillar	S70°W	29.74'
SE corner brick pillar	N75°W	22.82'
SW corner brick pillar	N35°W	25.67'
Angle point brick pillar (S. joint)	N20°W	37.60'
Kent Co. Mon. (E-1, T6N, R10W)	West	70.58'

STATE OF MICHIGAN
KIRK BREITELS
LAND SURVEYOR
30077
LICENSED LAND SURVEYOR

Signed by Kirk Breitels Date 4/19/96

Surveyor's Michigan License No. 30077

FORM APPROVED BY MICHIGAN STATE BOARD OF PROFESSIONAL SURVEYORS, JAN. 28, 1971
REVISED MAY 14,1975
REVISED JAN., 1983
REVISED OCT., 1995