

**SURVEY & REMONUMENTATION**

MAR 03 1998

**SECTION**

**LAND CORNER RECORDATION CERTIFICATE**  
 Filing Requirement of Act 74, Mich. P.A. 1970  
 KENT COUNTY REMONUMENTATION

STATE OF MICHIGAN  
 COUNTY OF KENT  
 RECEIVED FOR RECORD  
 97 OCT 15 AM 8:50  
 REG. OF DEEDS  
*Eric Sand*

**10196**

Register of Deeds Stamp & File Number

For corners in

Kent (County)	Located in: Ada Township	Corner Code #
1. Public Land Survey	T <u>7N</u> R <u>10W</u>	<u>F-1</u>
	T _____ R _____	_____
	T _____ R _____	_____
	T _____ R _____	_____
2. Property Controlling in Section	S _____ T _____ R _____	_____
	S _____ T _____ R _____	_____
3. Miscellaneous Property in Sec.	S _____ T _____ R _____	_____
	S _____ T _____ R _____	_____
4. Lot No. _____, Recorded Plat _____		
5. Private Claims _____		

I, Randy Kolehouse, in a field survey on April 10 19 97, do hereby certify that under requirements of P.A. 74 Michigan P.A. of 1970, the corner points mentioned in lines 1 and 2 above were in conformance with regulations and rules therefore as required in the current manual of survey instructions of the United States Department of the interior, Bureau of Land Management or by a decree of a Court of Law and/or that the corner points mentioned in lines 3, 4 and 5 above were in conformance with the rules of the Michigan Board of Land Surveyors or by a Decree of a Court of Law; established, re-established, monumented, re-monumented, recovered, found as expressed below:

**NOTE: Not more than 4 corners, all in the same town and range, may be recorded on this certificate.**

A. Description of original monument and accessories and/or subsequent restoration:

F-1 This corner was not originally set by the G.L.O.

1984 L.C.R.C. #3964 Exxel Engineering Set K.C. Monument  
 1992 L.C.R.C. #6262 Chris Marschall K.C. Monument

P.A. 345 1990 KENT COUNTY  
 PEER APPROVED 5/22/97  
 CHAIRMAN *Harry J. Huber*

Note: This corner is not common with F-13, T8N, R10W.

This corner was originally approved by the Kent County Remonumentation Peer Group and monumented by Exxel Engineering on 9/7/84 and was recorded per L.C.R.C. #3964.

B. Description of corner evidence found and/or method applied in restoring or reestablishing corner:

F-1 Found a Standard Kent County Monument on the Township line on the C/L of 4 Mile Road (gravel) running East and West per L.C.R.C.'s #3964 and #6262 as set by Exxel Engineering on line with the Southerly Section corners of Section 33, T8N, R10W, holding a computed government distance of 270.93' West of the South 1/4 corner of Section 33, T8N, R10W.

L.C.R.C. #3964

L.C.R.C. #6262

SE cor hse fndn (conc) N 26° E 126.49'  
 Nail & remon tag in SE sde 14" Spruce N 60° E 56.08' (m. 56.40')  
 Nail & remon tag in SW sde 17" Oak S 55° E 114.55'  
 Nail & remon tag in W sde 10" Hickory S 01° W 45.55'  
 Nail & remon tag in N sde 34" Oak S 75° W 53.41'


Nail & tag W sd. 16" Hickory S 00 W 72.03'  
 Nail & tag W sd. 10" Hickory S 02 E 45.49'  
 Nail & tag SE sd. 18" Spruce N 58 E 56.34' (m. 56.40')  
 Nail & tag SW sd. 20" Oak S 57 E 114.51' (m. 114.55')  
 Nail & tag N sd. 38" Oak S 73 W 53.38' (m. 53.41')  
 Mon F13 8N 10W N 90 E 270.87'

The selected location is accepted by me and is generally accepted by professional surveyors as the best available evidence of the position of the original corner.

C. Description of monument for corner and accessories established to perpetuate locating the position of the corner:

F-1 Standard Kent County Monument

Nail & K.C. remon. tag on W side 16" Hickory South 72.03'  
 Nail & K.C. remon. tag on W side 10" Hickory S 02° E 45.49'  
 Nail & K.C. remon. tag on SE side 18" Spruce N 58° E 56.40'  
 Nail & K.C. remon. tag on SW side 20" Oak S 57° E 114.55'  
 Nail & K.C. remon. tag on N side 38" Oak S 73° W 53.41'  
 K.C. Mon., E-13, T8N, R10W, East 270.87'

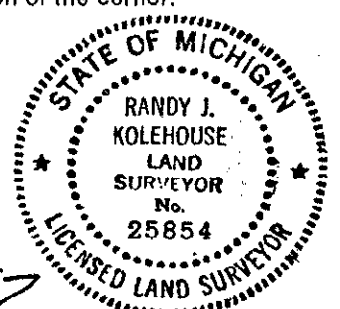

Signed by *Randy J. Kolehouse* Date 8-1-97

EARTH TECH

Surveyor's Michigan License No. 25854